

SURVEY & REMONUMENTATION

OCT 24 1994

COMMISSION

OTTAWA COUNTY REMONUMENTATION

LAND CORNER RECORDATION CERTIFICATE
 Filing Requirement of Act 74, Mich. P.A. 1970

RECORDED

Dorothy Chalkman
 REGISTER OF DEEDS
 OTTAWA COUNTY, MI

For corners in

<u>Ottawa</u> (County)	Located In:	Corner Code #
1. Public Land Survey	T <u>6N</u> R <u>16W</u>	<u>K-13 (SW. Cor. Sec 36)</u>
	T _____ R _____	<u>Port Sheldon Twp.</u>
	T _____ R _____	_____
	T _____ R _____	_____
2. Property Controlling in Section	S _____ T _____ R _____	_____
	S _____ T _____ R _____	_____
3. Miscellaneous Property in Sec.	S _____ T _____ R _____	_____
	S _____ T _____ R _____	_____
4. Lot No. _____, Recorded Plat _____		
5. Private Claims _____		

Register of Deeds Stamp & File Number

I, Gerald T. Ford, in a field survey on April 1, 19 94, do hereby certify that under requirements of P.A. 74, Michigan P.A. of 1970, the corner points mentioned in lines 1 and 2 above were in conformance with regulations and rules therefore as required in the current manual of survey instructions of the United States Department of the Interior, Bureau of Land Management or by a decree of a Court of Law and/or that the corner points mentioned in lines 3, 4 and 5 above were in conformance with the rules of the Michigan Board of Land Surveyors or by a Decree of a Court of Law; established, re-established, monumented, re-monumented, recovered, found as expressed below:

NOTE: Not more than 4 corners, all in the same town and range, may be recorded on this certificate.

A	B	C	D	E	F	G	H	I	J	K	L
2	6	5	4	3	2	1					
3											
4	7	8	9	10	11	12					
5											
6	18	17	16	15	14	13					
7											
8	19	20	21	22	23	24					
9											
10	30	29	28	27	26	25					
11											
12	31	32	33	34	35	36					
13											

A. Description of original monument and accessories and/or subsequent restoration:

K-13 Government Land Office Survey Notes 1832 - Surveyor, Calum Britian 10" Pine for corner Not Witnesses	K-13 Recorded in Liber 2, Page 23, February 16, 1973 Found Pinched Pipe Park Twp. Corner CL Manhole	E 6.34' NE 71.20'
--	--	------------------------------------

B. Description of corner evidence found and/or method applied in restoring or reestablishing corner:

K-13 Found pinched pipe in monument box and accepted it as a careful and faithful perpetuation of the position of the original corner Found Nail in W Face of Power Pole CL Hydrant Found Nail & Cap E Face of Power Pole CL Manhole Found cast iron mon. in mon box (K-1, T5N, R16W)	AZ 173°01' 153.19' AZ 133°00' 37.10' AZ 37°50' 45.09' NE 71.18' AZ 89°46' 6.38'
--	--


C. Description of monument for corner and accessories established to perpetuate locating the position of the corner:

K-13 Replaced pinch pipe in Monument Box with O.C. Remonumentation Iron & Cap AZ - Michigan State Grid Direction O.C. Remon tag & nail in E face P. Pole "X" Cut top of N. Spigot Hydrant O.C. Remon tag & nail in E face P Pole "X" cut SW bolt top flange of Watermain OC Mon. in Mon Box K-1, T5N, R16W	AZ. 172°38' 153.51' AZ. 132°34' 36.88' AZ. 37°55' 45.11' AZ. 72°36' 81.73' AZ. 89°46' 6.38'
--	--

P.A. 345 OTTAWA COUNTY

PEER APPROVED

W. J. Ford
Gerald T. Ford

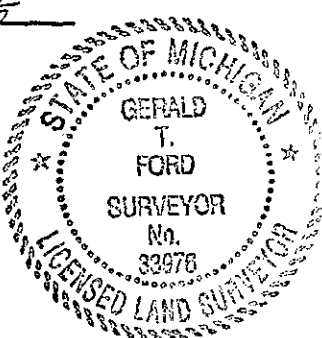

Signed by Gerald T. Ford Date July 13, 1994

Surveyor's Michigan License No. 33976