

**SURVEY & REMONUMENTATION**

DEC 01 1993

**COMMISSION**

**OTTAWA COUNTY REMONUMENTATION**

RECORDED

93 NOV 11 AM 11:55

**LAND CORNER RECORDATION CERTIFICATE**  
**Filing Requirement of Act 74, Mich. P.A. 1970**

*Phyllis Holman*  
 REGISTER OF DEEDS  
 OTTAWA COUNTY, MI

For corners in

Ottawa

(County)

Located In:

Corner Code #

- |                                    |   |           |   |            |                            |
|------------------------------------|---|-----------|---|------------|----------------------------|
| 1. Public Land Survey              | T | <u>6N</u> | R | <u>16W</u> | <u>L-11 (N 1/4 Sec 36)</u> |
|                                    | T | _____     | R | _____      | <u>Port Sheldon Twp.</u>   |
|                                    | T | _____     | R | _____      | _____                      |
|                                    | T | _____     | R | _____      | _____                      |
| 2. Property Controlling in Section | S | _____     | T | _____      | _____                      |
|                                    | S | _____     | T | _____      | _____                      |
| 3. Miscellaneous Property in Sec.  | S | _____     | T | _____      | _____                      |
|                                    | S | _____     | T | _____      | _____                      |

Register of Deeds Stamp & File Number

4. Lot No. \_\_\_\_\_, Recorded Plat \_\_\_\_\_
5. Private Claims \_\_\_\_\_

	A	B	C	D	E	F	G	H	I	J	K	L	M
2	6	5	4	3	2	1							
3													
4	7	8	9	10	11	12							
5													
6	18	17	16	15	14	13							
7													
8	19	20	21	22	23	24							
9													
10	30	29	28	27	26	25							
11													
12	31	32	33	34	35	36							
13													

I, David R. Greer, in a field survey on September 13, 1993, do hereby certify that under requirements of P.A. 74, Michigan P.A. of 1970, the corner points mentioned in lines 1 and 2 above were in conformance with regulations and rules therefore as required in the current manual of survey instructions of the United States Department of the Interior, Bureau of Land Management or by a decree of a Court of Law and/or that the corner points mentioned in lines 3, 4 and 5 above were in conformance with the rules of the Michigan Board of Land Surveyors or by a Decree of a Court of Law; established, re-established, monumented, re-monumented, recovered, found as expressed below:

**NOTE: Not more than 4 corners, all in the same town and range, may be recorded on this certificate.**

A. Description of original monument and accessories and/or subsequent restoration:

Recorded in Liber 5 Page 98, Dec. 20, 1983

L-11

Set cast iron monument

- SW cor bldg NNE 75.22
- 16" pine NW 51.87
- 14" pine WNW 72.03
- Con Tele Ped SW 63.89

B. Description of corner evidence found and/or method applied in restoring or reestablishing corner:

L-11

Found cast iron monument and accepted it as a careful and faithful perpetuation of the position of the original corner

- SW cor bldg NNE 75.22
- 16" Pine NW 51.87
- 14" Pine WNW 72.03
- Con Tele Ped SW 63.89


C. Description of monument for corner and accessories established to perpetuate locating the position of the corner:

L-11

Raised C.I.M. in Monument Box with O.C. Remonument Iron & Cap

AZ - Michigan State Plane Grid Direction

- OC Remon tag & nail in NE side 10" Pine AZ. 293°17 76.75'
- OC Remon tag & nail in NE side Twin 14" Cherry AZ. 332°32 99.16'
- NW Cor. Block Bldg. AZ. 13°28 90.66'
- NE Cor. Hse. Conc. Block AZ. 193°05 180.28'

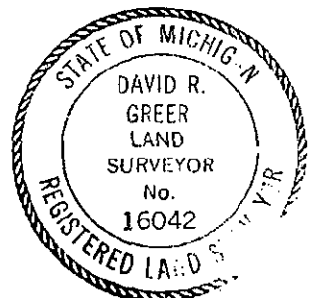

Signed by

*David R. Greer*

Date

Sept. 13, 1993

Surveyor's Michigan License No. 16042