

SURVEY & REMONUMENTATION

APR 25 1995

OTTAWA COUNTY REMONUMENTATION
LAND CORNER RECORDATION CERTIFICATE
Filing Requirement of Act 74, Mich. P.A. 1970

RECORDED

94 DEC -8 PM 12:31

COMMISSION

Richard Kellerman
REGISTER OF DEEDS
OTTAWA COUNTY, MI

corners in

| | | |
|--|--------------------------|--------------------------------|
| <u>Ottawa</u> <small>(County)</small> | Located In: | Corner Code # |
| Public Land Survey | T <u>6N</u> R <u>16W</u> | <u>M-6 (E 1/4 Cor Sec. 13)</u> |
| | T _____ R _____ | <u>Port Sheldon Twp.</u> |
| | T _____ R _____ | _____ |
| | T _____ R _____ | _____ |
| Property Controlling | S _____ T _____ R _____ | _____ |
| in Section | S _____ T _____ R _____ | _____ |
| Miscellaneous | S _____ T _____ R _____ | _____ |
| Property in Sec. | S _____ T _____ R _____ | _____ |

Register of Deeds Stamp & File Number

Lot No. _____, Recorded Plat _____
Private Claims _____

| | A | B | C | D | E | F | G | H | I | J | K | L | M |
|----|----|----|----|----|----|----|---|---|---|---|---|---|---|
| 2 | 6 | 5 | 4 | 3 | 2 | 1 | | | | | | | |
| 3 | | | | | | | | | | | | | |
| 4 | 7 | 8 | 9 | 10 | 11 | 12 | | | | | | | |
| 5 | | | | | | | | | | | | | |
| 6 | 16 | 17 | 16 | 15 | 14 | 13 | | | | | | | |
| 7 | | | | | | | | | | | | | |
| 8 | 19 | 20 | 21 | 22 | 23 | 24 | | | | | | | |
| 9 | | | | | | | | | | | | | |
| 10 | 30 | 29 | 28 | 27 | 26 | 25 | | | | | | | |
| 11 | | | | | | | | | | | | | |
| 12 | 31 | 32 | 33 | 34 | 35 | 36 | | | | | | | |
| 13 | | | | | | | | | | | | | |

John P. Clapp in a field survey on November 14, 1994

whereby certify that under requirements of P.A. 74, Michigan P.A. of 1970, the corner points mentioned in lines 1 and 2 above were in conformance with regulations and rules therefore as required in the present manual of survey instructions of the United States Department of the Interior, Bureau of Land Management or by a decree of a Court of Law and/or that the corner points mentioned in lines 3, 4 and 5 above were in conformance with the rules of the Michigan Board of Land Surveyors or by a Decree of a Court of Law; established, re-established, monumented, re-monumented, recovered, found as recited below:

NOTE: Not more than 4 corners, all in the same town and range, may be recorded on this certificate.

Description of original monument and accessories and/or subsequent restoration:

| | | |
|--|---|--|
| <p>M-6 Gov't Land Office Survey Notes May 1832 - Surveyor, Calvin Britain Post 5" Beech S77°W 11 links 4" Hemlock N30°W 9 links</p> | <p>M-6 Recorded in Liber 1 Page 31, June 29, 1971 Iron Pipe Telephone Pole SW 56.45' Telephone Pole SE 45.36' Power Pole NW 55.64' Guy Pole NE 42.04' CL St. Sign SE 25.27'</p> | <p>M-6 Recorded in Liber 5 Page 319, August 9, 1988 Set Cast Iron Monument Olive Twp Cor S 60.73' 4" Poplar E 31.30' 28" Ash SW 112.40' Power Pole NW 55.90'</p> |
|--|---|--|

Description of corner evidence found and/or method applied in restoring or reestablishing corner:

P.A. 345 OTTAWA COUNTY


PEER APPROVED 11/21/94

| | | | |
|------------|--|----------|---------|
| M-6 | Found cast iron monument and accepted it as a careful and faithful perpetuation of the position of the original corner | | |
| | Found Nail & Tag in NE Face of 32" Ash | AZ. 254° | 112.44' |
| | Found Nail & Tag in NE Face of Power Pole | AZ. 309° | 55.99' |
| | Found Nail & Tag in NW Side of Guy Pole | AZ. 38° | 42.55' |
| | Olive Township Corner | AZ. 180° | 60.71' |

Richard D. Nedewell

Description of monument for corner and accessories established to perpetuate locating the position of the corner:

| | | | |
|------------|---|----------|---------|
| M-6 | Found Ottawa County Cast Iron Monument | | |
| | O.C. Remon tag & nail in S Side 32" Ash | AZ. 254° | 112.36' |
| | O.C. Remon tag & nail in NE Side 12" Twin Maple | AZ. 133° | 78.79' |
| | O.C. Remon tag & nail in S Side 13" Maple | AZ. 63° | 78.84' |
| | Olive Township Corner | AZ. 180° | 60.71' |
| | O.C. Remon tag & nail in NE Side Power Pole | AZ. 309° | 56.14' |

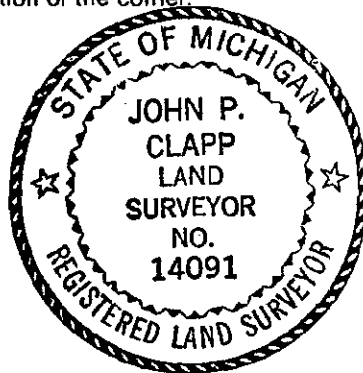

Signed by John P. Clapp Date November 15, 1994
Surveyor's Michigan License No. 14091