

SURVEY & REMONUMENTATION

APR 25 1995

COMMISSION

OTTAWA COUNTY REMONUMENTATION
LAND CORNER RECORDATION CERTIFICATE
Filing Requirement of Act 74, Mich. P.A. 1970

RECORDED

94 DEC -8 PM 12:31

Richard R. Anderson
REGISTER OF DEEDS
OTTAWA COUNTY, MI

corners in

<u>Ottawa</u> (County)	Located In:	Corner Code #
Public Land Survey	T <u>6N</u> R <u>16W</u>	<u>M-7 (SE Cor, Sec 13)</u>
	T _____ R _____	<u>Port Sheldon Twp.</u>
	T _____ R _____	_____
	T _____ R _____	_____
Property Controlling in Section	S _____ T _____ R _____	_____
Miscellaneous Property in Sec.	S _____ T _____ R _____	_____

Register of Deeds Stamp & File Number

Lot No. _____, Recorded Plat _____
Private Claims _____

John P. Clapp, November 14, 1994

in a field survey on _____, 19____
hereby certify that under requirements of P.A. 74, Michigan P.A. of 1970, the corner points mentioned in lines 1 and 2 above were in conformance with regulations and rules therefore as required in the present manual of survey instructions of the United States Department of the Interior, Bureau of Land Management or by a decree of a Court of Law and/or that the corner points mentioned in lines 3, 4 and 5 above were in conformance with the rules of the Michigan Board of Land Surveyors or by a Decree of a Court of Law; established, re-established, monumented, re-monumented, recovered, found as expressed below:

NOTE: Not more than 4 corners, all in the same town and range, may be recorded on this certificate.

Description of original monument and accessories and/or subsequent restoration:

M-7 Gov't Land Office Survey Notes May 1832 - Surveyor, Calvin Britain Post 6" Beech S24°W 32 links 5" W. Ash N22°W 7 links NOTE: See additional recordings on reverse side	M-7 Recorded in Liber 1 Page 35, June 29, 1971 Iron Pipe CL Street Sign SE 71.47' Telephone Pole SE 79.03' Power Pole NW 37.76' CL Stanchion SW 54.20' 6" Pine SW 77.38'	M-7 Recorded in Liber 4, Page 115 October 29, 1980 Steel Rod in Monument Box Street Sign SE 71.47' T. Pole SE 79.03' Power Pole NW 37.76' P/L Stanchion SW 54.20' 6" Pine SW 77.38' Olive T. Cor S 48.77'
--	---	---

Description of corner evidence found and/or method applied in restoring or reestablishing corner:

M-7 Found cast iron monument and accepted it as a careful and faithful perpetuation of the position of the original corner Found Nail & Cap in face of Power Pole Found Olive Twp. Corner Street Sign Pipeline Stanchion Telephone Pedestal Found Nail in face of 12" Pine	AZ. 288° 37.76' AZ. 180° 48.75' AZ. 158° 71.80' AZ. 225° 53.94' AZ. 76° 45.90' AZ. 223° 77.35'
--	---


P.A. 345 OTTAWA COUNTY

PEER APPROVED 11/21/94

Richard P. Nedowald

Description of monument for corner and accessories established to perpetuate locating the position of the corner:

M-7 Found Ottawa County Cast Iron Monument O.C. Remon tag & nail in NW Face of 12" Pine O.C. Remon tag & nail in S Face of Power Pole O.C. Remon tag & nail in S Face of 12" Pine Olive Township Corner	AZ. 223° 77.73' AZ. 288° 38.32' AZ. 58° 52.73' AZ. 180° 48.75'
---	---

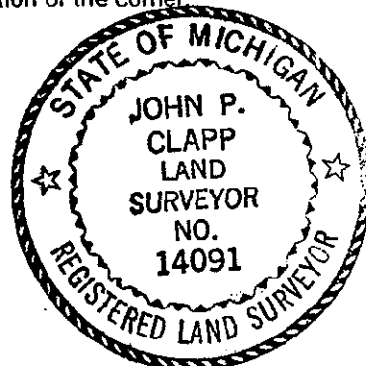

signed by John P. Clapp *John P. Clapp* Date November 15, 1994

Surveyor's Michigan License No. 14091

FORM APPROVED BY MICHIGAN STATE BOARD OF LAND SURVEYORS, JAN. 28, 1971
REVISED MAY 14, 1975
REVISED JAN., 1983

OTTAWA

M-7

Recorded in Liber 7, Page 79, Dec. 20, 1983

Set Cast Iron Monument

Olive Township Corner	S	48.75'
Telephone Pole	SE	79.00'
Power Pole	WNW	37.80'
Telephone Pedestal	ENE	45.90'

RECORDED
INDEXED
DEC 21 1983