

DEC 01 1993

COMMISSION

OTTAWA COUNTY REMONUMENTATION
LAND CORNER RECORDATION CERTIFICATE
Filing Requirement of Act 74, Mich. P.A. 1970

RECORDED

93 NOV 11 AM 11:56

Phyllis Robinson
REGISTER OF DEEDS
OTTAWA COUNTY, MI

For corners in

<u>Ottawa</u> (County)	Located In:	Corner Code #
1. Public Land Survey	T <u>6N</u> R <u>16W</u>	<u>M-11 (NE 1/4 Sec 36)</u>
	T _____ R _____	<u>Port Sheldon Twp.</u>
	T _____ R _____	_____
	T _____ R _____	_____
2. Property Controlling in Section	S _____ T _____ R _____	_____
	S _____ T _____ R _____	_____
3. Miscellaneous Property in Sec.	S _____ T _____ R _____	_____
	S _____ T _____ R _____	_____
4. Lot No. _____, Recorded Plat _____		
5. Private Claims _____		

Register of Deeds Stamp & File Number

I, David R. Greer, in a field survey on September 13, 19 93, do hereby certify that under requirements of P.A. 74, Michigan P.A. of 1970, the corner points mentioned in lines 1 and 2 above were in conformance with regulations and rules therefore as required in the current manual of survey instructions of the United States Department of the Interior, Bureau of Land Management or by a decree of a Court of Law and/or that the corner points mentioned in lines 3, 4 and 5 above were in conformance with the rules of the Michigan Board of Land Surveyors or by a Decree of a Court of Law; established, re-established, monumented, re-monumented, recovered, found as expressed below:

NOTE: Not more than 4 corners, all in the same town and range, may be recorded on this certificate.

A	B	C	D	E	F	G	H	I	J	K	L	M
2	6	5	4	3	2	1						
3												
4	7	8	9	10	11	12						
5												
6	18	17	16	15	14	13						
7												
8	19	20	21	22	23	24						
9												
10	30	29	28	27	26	25						
11												
12	31	32	33	34	35	36						
13												

A. Description of original monument and accessories and/or subsequent restoration:


Recorded in Liber 5, Page 98, Dec. 20, 1983
M-11
Set cast iron monument
Olive Twp Cor S 35.64'
PP NW 44.45'
PP SE 79.05'
Cen of Street Sign SW 51.09'

B. Description of corner evidence found and/or method applied in restoring or reestablishing corner:

M-11
Found cast iron monument in monument box and accepted it as a careful and faithful perpetuation of the position of the original corner.
Olive Twp. Cor S 35.64'
PP NW 44.45'
PP SE 79.05'
Cen of Street Sign SW 51.90'

C. Description of monument for corner and accessories established to perpetuate locating the position of the corner:

M-11
Raised C.I.M. in Monument Box with O.C. Remonumentation Iron & Cap
AZ = Michigan State Plane Grid Direction
Found P.K. Nail in NE Side P. Pole AZ. 149°50' 79.20'
Found Nail in the NE Side Guy Pole AZ. 313°30' 44.72'
SW Cor Brick House AZ. 74°17' 80.92'
NW Cor Brick House AZ. 56°16' 93.78'
A-11 T6N R15W Cast Iron Monument AZ. 178°07' 35.67'

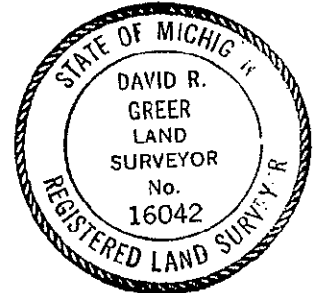

Signed by David R Greer

Date Sept. 13, 1993

Surveyor's Michigan License No. 16042