

FEB 24 2000

RECORDED

SECTION

OTTAWA COUNTY REMONUMENTATION

99 DEC -2 PM 1:12

LAND CORNER RECORDATION CERTIFICATE
Filing Requirement of Act 74, Mich. P.A. 1970

For corners in
OTTAWA
(County)

Located In: Corner Code #

- 1. Public Land Survey T 6N R 16W M-12 E 1/4 corner
T R Section 36 Port
T R Sheldon Twp
T R
- 2. Property Controlling S T R
in Section S T R
- 3. Miscellaneous S T R
Property in Sec. S T R

[Signature]
REGISTER OF DEEDS
OTTAWA COUNTY, MI

Seg. 2

Register of Deeds Stamp & File Number

4. Lot No. _____, Recorded Plat _____
5. Private Claims _____

I, Randal J. Vugteveen, in a field survey on October 26, 1999 do hereby state that under requirements of P.A. 74, Michigan P.A. of 1970, the corner points mentioned in lines 1 and 2 above were in conformance with regulations and rules therefore as required in the current manual of survey instructions of the United States Department of the Interior, Bureau of Land Management or by a decree of a Court of Law and /or that the corner points mentioned in lines 3, 4 and 5 above were in conformance with the rules of the Michigan Board of Land Surveyors or by a Decree of a Court of Law; established, re-established, monumented, recovered, found as expressed below:

NOTE: Not more than 2 corners, all in the same town and range, may be recorded on this certificate.

1	A	B	C	D	E	F	G	H	I	J	K	L	M
2		6		5		4		3		2		1	
3													
4		7		8		9		10		11		12	
5													
6		18		17		16		15		14		13	
7													
8		19		20		21		22		23		24	
9													
10		30		29		28		27		26		25	
11													
12		31		32		33		34		35		36	
13													

A. Description of original monument and accessories and/or subsequent restoration:

M-12 Peer Approved November 21, 1994
Liber 1, Page 432 (Clapp)
Found Ottawa County Cast Iron Monument
Nail & Remon Tag in NW face 9" Pine Az 236° 85.83'
Nail & Remon Tag in WNW face Power Pole Az 198° 86.39'
Nail & Remon Tag in N face 6" Pine Az 111° 143.33'
Olive Township Corner Az 180° 18.13'

APPROVED 11/15/99
[Signature]

B. Description of corner evidence found and/or method applied in restoring or reestablishing corner:

M-12 Corner Removed by Ottawa County Road Commission September 1999

Found Nail & Remon Tag in NW side 12" Pine S56°W 85.83'
Found Nail & Remon Tag in W side Power Pole S18°W 86.39'
Found Nail & Remon Tag in N side 8" Pine S69°E 143.33'


Accepted position of intersection of witness ties as a careful and faithful perpetuation of the position of the original corner.

Set 3/4" X 36" Solid Bar with Ottawa Remon Cap at intersection of witness ties.

C. Description of monument for corner and accessories established to perpetuate locating the position of the corner:

M-12 3/4" X 36" Solid Bar with Ottawa County Remon Cap

Found Nail and Remon Tag in NW side 12" Pine S56°W 85.83'
Found Nail and Remon Tag in W side Power Pole S18°W 86.39'
Found Nail and Remon Tag in N side 8" Pine S69°E 143.33'
Center Street sign N80°E 68.75'
Centerline Pipeline Marker N35°W 31.11'
N & S road East 43'
E & W road South 21'

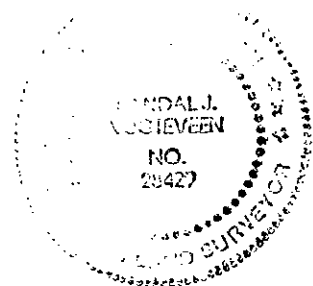

99-00 URMEN
Receipt #54945

Signed by *[Signature]*
Surveyor's Michigan License No. 28429

Date Nov. 15, 1999