

# SURVEY & REMONUMENTATION

APR 25 1995

COMMISSION

For corners in

## OTTAWA COUNTY REMONUMENTATION LAND CORNER RECORDATION CERTIFICATE Filing Requirement of Act 74, Mich. P.A. 1970

RECORDED

94 DEC -8 PM 12:32

*Robert Williams*  
REGISTER OF DEEDS  
OTTAWA COUNTY, MI

<u>Ottawa</u> (County)	Located In:	Corner Code #
1. Public Land Survey	T <u>6N</u> R <u>16W</u>	<u>M-13 (SE Cor. Sec. 36)</u>
	T _____ R _____	<u>Port-Sheldon Twp.</u>
	T _____ R _____	_____
	T _____ R _____	_____
2. Property Controlling in Section	S _____ T _____ R _____	_____
	S _____ T _____ R _____	_____
3. Miscellaneous Property in Sec.	S _____ T _____ R _____	_____
	S _____ T _____ R _____	_____

Register of Deeds Stamp & File Number

4. Lot No. \_\_\_\_\_, Recorded Plat \_\_\_\_\_  
5. Private Claims \_\_\_\_\_

John P. Clapp in a field survey on November 15, 1994

do hereby certify that under requirements of P.A. 74, Michigan P.A. of 1970, the corner points mentioned in lines 1 and 2 above were in conformance with regulations and rules therefore as required in the current manual of survey instructions of the United States Department of the Interior, Bureau of Land Management or by a decree of a Court of Law and/or that the corner points mentioned in lines 3, 4 and 5 above were in conformance with the rules of the Michigan Board of Land Surveyors or by a Decree of a Court of Law; established, re-established, monumented, re-monumented, recovered, found as expressed below:

NOTE: Not more than 4 corners, all in the same town and range, may be recorded on this certificate.

	A	B	C	D	E	F	G	H	I	J	K	L	M
2	6	5	4	3	2	1							
3													
4	7	8	9	10	11	12							
5													
6	18	17	16	15	14	13							
7													
8	19	20	21	22	23	24							
9													
10	30	29	28	27	26	25							
11													
12	31	32	33	34	35	36							
13													

6. Description of original monument and accessories and/or subsequent restoration:

<b>M-13</b> Gov't Land Office Survey Notes May 1832 - Surveyor, Calvin Britain Post 10" Tamarack N47°W 110 links 8" Pine N88°E 93 links	<b>M-13</b> Recorded in Liber 4 Page 323, June 10, 1982 Found Iron Pipe CL 144th Avenue E 81 ± Power Pole N 164.90' CL Hydrant NE 34.41' Power Pole S 52.03'	<b>M-13</b> Recorded in Liber 4 Page 338, Sept. 24, 1982 Set Cast Iron Monument Hydrant N 34.50' P.P. S 51.60' P/L Marker SE 37.25'
--	---	---

7. Description of corner evidence found and/or method applied in restoring or reestablishing corner:


**M-13**  
Found cast iron monument and accepted it as a careful and faithful perpetuation of the position of the original corner  
Found Nail & Tag in East Face of Power Pole AZ. 180° 52.01'  
CL Hydrant AZ 28° 34.41'

P.A. 345 OTTAWA COUNTY  
PEER APPROVED 11/21/94

*Robert Williams*

8. Description of monument for corner and accessories established to perpetuate locating the position of the corner:

**M-13**  
Found Ottawa County Cast Iron Monument  
Set O.C. Remon tag & nail in W Face of Power Pole AZ. 358° 164.92'  
CL Hydrant AZ. 29° 34.41'  
Set O.C. Remon tag & nail in W Face of Power Pole AZ. 178° 52.03'  
CL 144th Avenue AZ. 90° 86' ±  
Set O.C. Remon tag & nail N face of Power Pole AZ. 105° 121.50'

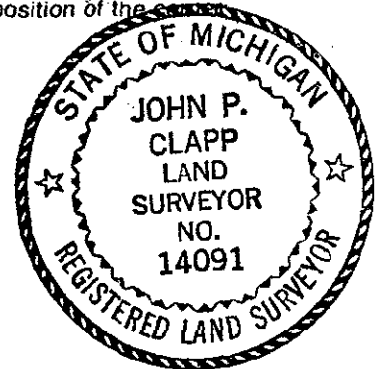

Signed by John P. Clapp Date Nov. 16, 1994

Surveyor's Michigan License No. 14091

FORM APPROVED BY MICHIGAN STATE BOARD OF LAND SURVEYORS, JAN. 28, 1971  
REVISED MAY 14, 1975  
REVISED JAN., 1983