FEB 2 4 2000

RECORDED

	UMA I	ttawa County Remo CORNER RECORI	numentation	99 OCT 27	PM 1:50
SECTION	Filing	g Requirement of A		// I C	
For corners in		•	1		2011-
Ottawa	Located in:	Corner Code #		REGISTER	of Deeds
(County)				OT STAN	THE V. MI
1. Public Land Survey	T <u>7N</u> R T R_ T R_	W. 1/4 corr	ner of Section 31 wn Township		
 Property Controlling in Section Miscellaneous Property in Sec. 	TR_ S TR_ S TR_ S TR_ S TR_			Register of Deeds St	amp & File Number
4. Lot No, Reco	orded Plat				
5. Private Claims I, Maurice J. Rosema requirements of P.A. 74, Michig conformance with regulations an United States Department of the that the corner points mentione Board of Land Surveyors or b recovered, found as expressed by	, in a field survey on	Sept. 11 , 1999 do r points mentioned in lines in the current manual of st nagement or by a decree or rere in conformance with the	hereby state that under 1 and 2 above were in urvey instructions of the f a Court of Law and /or e rules of the Michigan	A B C D E F C 1 2 -6-5-4 3 4-7-8-9-5 6-18-17-16-7 8-19-20-21	-10 -11 -12 -13 -13 -22 -23 -24
NOTE: Not more than 2 cor on this certificate.	mers, all in the same town	and range, may be reco	rided	9 10 30 29 28 11 1 31 32 33 13	-27 -26 -25 - 25 - 36 - 35 - 36 - 36 - 36 - 36 - 36 - 3
A. Description of original me	onument and accessorie	s and/or subsequent re	storation:		
A-12					
Not set by GLO	LCRC per Liber 2, Page 123 (Bonnema - 1976) 1/2" iron Nail in side T. pole - NE. 52.18' Nail in side 30" Oak - NNW. 158.80' PK - E. 0.78' T iron - N. 49.89"			10/18/	
B. Description of corner evi A-12 Found Cast iron monume measured the following to Cast iron monument in m C/L "x" bit. conc. roads N	nt in monument box of the Cast iron monument box - N. 49.	0.78' E. of Twp. linement:	_		C.I. mon.
This position not establish best available evidence to	ned by original govern the position of the co	nment surveyors. Torner.	his monument is ac	ccepted as the	
C. Description of monument A-12					
Cast iron monument in m P.K. nail on Twp. line - W	onument box 0.78' E. 7. 0.78'	of twp. line (the fol	llowing witnesses a	re to the Cast iron mon	ument)

Set nail and remonumentation tag in E. side 4" Maple - S45°W 88.80'
Top of N. plastic fence post - N40°W 78.20'
Center of top of dome catch basin - S80°W 37.56'


Centerline of base of stop sign post - N65°E 45.55'
Set nail and remonumentation tag in SW. side light pole - S30°E 54.40'

Signed by	James !	9. E	Dona	
Surveyor's Michigan	cense No	27 59)	

September 11, 1999

E OF MICHIGA MAURICE J. ROSEMA LAND SURVEYOR NO. 27459 PROFESSIONA

Date

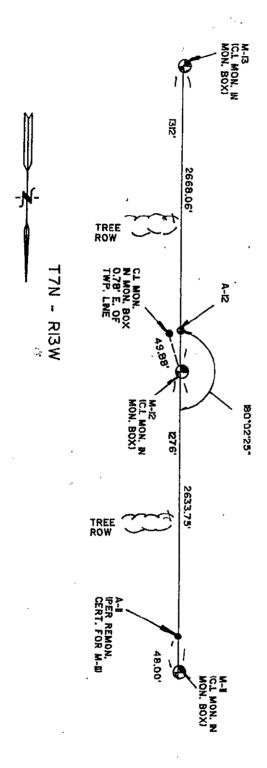

T7N - RI4W