

Ottawa County Remonumentation
LAND CORNER RECORDATION CERTIFICATE
 Filing Requirement of Act 74, Mich. P.A. 1970

RECORDED

96 DEC 18 PM 4:54

Reginald Robinson
 REGISTER OF DEEDS
 OTTAWA COUNTY, MI

For corners in

<u>Ottawa</u> (County)	Located In:	Corner Code #
1. Public Land Survey	T <u>7N</u> R <u>13W</u>	B-1 (N $\frac{1}{2}$ cor. Sec. 6)
	T _____ R _____	_____
	T _____ R _____	_____
	T _____ R _____	_____
2. Property Controlling in Section	S _____ T _____ R _____	_____
	S _____ T _____ R _____	_____
3. Miscellaneous Property in Sec.	S _____ T _____ R _____	_____
	S _____ T _____ R _____	_____

Register of Deeds Stamp & File Number

4. Lot No. _____, Recorded Plat _____
 5. Private Claims _____

	A	B	C	D	E	F	G	H	I	J	K	L	A
2	6		5		4		3		2		1		
3													
4	7		8		9		10		11		12		
5													
6	18		17		16		15		14		13		
7													
8	19		20		21		22		23		24		
9													
10	30		29		28		27		26		25		
11													
12	31		32		33		34		35		36		
13													

I, Maurice J. Rosema in a field survey on Dec. 6, 19 96, do hereby certify that under requirements of P.A. 74, Michigan P.A. of 1970, the corner points mentioned in lines 1 and 2 above were in conformance with regulations and rules therefore as required in the current manual of survey instructions of the United States Department of the Interior, Bureau of Land Management or by a decree of a Court of Law and/or that the corner points mentioned in lines 3, 4 and 5 above were in conformance with the rules of the Michigan Board of Land Surveyors or by a Decree of a Court of Law; established, re-established, monumented, re-monumented, recovered, found as expressed below:

NOTE: Not more than 4 corners, all in the same town and range, may be recorded on this certificate.

A. Description of original monument and accessories and/or subsequent restoration:

B-1	LCRC rec. in L 3, P 353	LCRC rec. in L 3, P 330	LCRC rec. in L 6, P 175
GLO - 1837	(1978) - steel fc post	(1979) - steel fc post	(1991) - steel fc post
Post	Tri 10"-18" Ash - N 11.20'	15" Cherry - SW 39.51'	P pole - SW 39.38'
10" Beech -	12" Cherry - S45°W 39.34'	Stump - S 36.91'	
N81°E 25 lks.	12" Apple - S30°E 62.53'	Fence to S - W 24.5'	
10" Beech -			Information from the files
N59°W 24 lks.			of Tru-Line Surveying
			B-13, T8N, R13W - E 269.33'

B. Description of corner evidence found and/or method applied in restoring or reestablishing corner:

B-1
 Found C.I. mon (top broken) on Twp. line on North edge of bent steel fence post.
 Found C.I. monument - E 269.33'


This corner not monumented by the original GLO survey. This monument is accepted as the best available evidence of the position of the corner.

RA. 345 OTTAWA COUNTY
 PEER APPROVED 12-9-96

M.J.R.

C. Description of monument for corner and accessories established to perpetuate locating the position of the corner:

B-1
 C.I. monument (on Township line)
 Nail and remon. tag in W side 12" Cor. Metal Pipe - S73°E 76.74'
 Nail and remon. tag in E side 5" Pine - S6°E 45.26'
 Nail and remon. tag in NW side P pole - S54°W 38.95'
 Nail and remon. tag in SE side 12" Ash - N36°E 219.30'
 C.I. monument - S86°E 269.33'
 On centerline of E-W gravel road

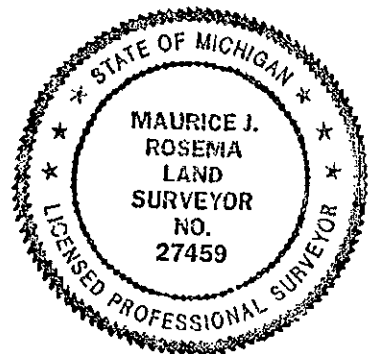

Signed by *Maurice J. Rosema* Date Dec. 9, 1996
 Surveyor's Michigan License No. 27459