

FEB 24 2000

RECORDED

99 OCT 27 PM 1:49

Ottawa County Remonumentation
LAND CORNER RECORDATION CERTIFICATE
Filing Requirement of Act 74, Mich. P.A. 1970

SECTION

For corners in

Ottawa

(County)

Located In:

Corner Code #

1. Public Land Survey

T7N R13W

B-7

T R

N 1/4 corner Section 19

T R

Allendale Township

T R

2. Property Controlling
in Section

S T R

S T R

3. Miscellaneous
Property in Sec.

S T R

S T R

Mary Schellton
REGISTER OF DEEDS
OTTAWA COUNTY MI

Register of Deeds Stamp & File Number

4. Lot No. _____, Recorded Plat _____
5. Private Claims _____

I, Maurice J. Rosema, in a field survey on July 28, 1999 do hereby state that under requirements of P.A. 74, Michigan P.A. of 1970, the corner points mentioned in lines 1 and 2 above were in conformance with regulations and rules therefore as required in the current manual of survey instructions of the United States Department of the Interior, Bureau of Land Management or by a decree of a Court of Law and /or that the corner points mentioned in lines 3, 4 and 5 above were in conformance with the rules of the Michigan Board of Land Surveyors or by a Decree of a Court of Law; established, re-established, monumented, recovered, found as expressed below:

NOTE: Not more than 2 corners, all in the same town and range, may be recorded on this certificate.

A	B	C	D	E	F	G	H	I	J	K	L	P
1												
2	6		5		4		3		2		1	
3												
4	7		8		9		10		11		12	
5												
6	18		17		16		15		14		13	
7	●											
8	19		20		21		22		23		24	
9												
10	30		29		28		27		26		25	
11												
12	31		32		33		34		35		36	
13												

A. Description of original monument and accessories and/or subsequent restoration:

B-7

GLO - 1832

Sibley and Lyon D.S.

Set H.M.P.

12" Beech - S42°W

16 links

14" Elm - N7°E

35 links

LCRC per Liber 5, Page 207

(Rosema - 1985)

Found iron pipe (per Joiner records)

Nail in E side 6" Maple - S 42.53'

Nail in N side 10" Maple - W 51.09'

Nail in NW side 15" Maple - SW 2.82'

First metal fence post - N 23.27'

On fence line to North

LCRC per Liber 6, Page 175

(Joiner - 1991)

Replaced 1/2" iron pipe with C.I. monument

8" Maple - S 42.53'

16" Maple - SW 1.84'

16" Tree - W 51.05'

1/2" rerod - N 5.53'

B. Description of corner evidence found and/or method applied in restoring or reestablishing corner:

B-7

Found C.I. monument at grade on fence line to North and at field divisions East - West - North - South

Found nail in N side 10" Maple - N86°W 51.10'

Found nail in NW side 15" Maple - S29°W 2.86'

Found nail in E side 7" Maple - S0°E 42.60'

OTTAWA COUNTY

10/18/99
YDZ

I hereby accept this corner as a correct and accurate perpetuation of the position of the original corner.

C. Description of monument for corner and accessories established to perpetuate locating the position of the corner:

B-7

C.I. monument


Set nail and remonumentation tag in N side 10" Maple - N86°W 51.10'

Set nail and remonumentation tag in NW side 15" Maple - S29°W 2.86'

Set nail and remonumentation tag in E side 7" Maple - S0°E 42.60'

Base of T-fence post - N2°E 70.65'

On fence line to North and at field divisions East - West - North - South

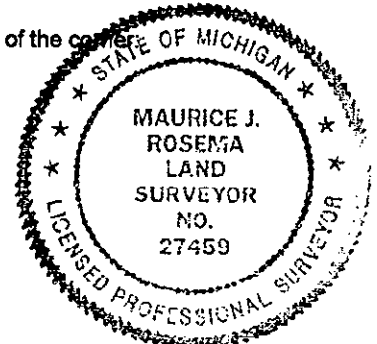

Signed by *Maurice J. Rosema*
Surveyor's Michigan License No. 27459

Date October 16, 1999