

# SURVEY & REMONUMENTATION

APR 24 1995

Ottawa County Remonumentation

RECORDED

COMMISSION

LAND CORNER RECORDATION CERTIFICATE

94 DEC 15 AM 11:48

Filing Requirement of Act 74, Mich. P.A. 1970

*Deborah K. Robinson*  
REGISTER OF DEEDS  
OTTAWA COUNTY, MI

For corners in

Ottawa (County)	Located In:	Corner Code ##
1. Public Land Survey	T <u>7N</u> R <u>13W</u>	<u>C-5</u>
	T _____ R _____	_____
	T _____ R _____	_____
	T _____ R _____	_____
2. Property Controlling in Section	S _____ T _____ R _____	_____
	S _____ T _____ R _____	_____
3. Miscellaneous Property in Sec.	S _____ T _____ R _____	_____
	S _____ T _____ R _____	_____

Register of Deeds Stamp & File Number

4. Lot No. \_\_\_\_\_, Recorded Plat \_\_\_\_\_  
5. Private Claims \_\_\_\_\_

Maurice J.  
Rosema

Nov. 26 94

I, \_\_\_\_\_, in a field survey on \_\_\_\_\_, 19 \_\_\_\_\_, do hereby certify that under requirements of P.A. 74, Michigan P.A. of 1970, the corner points mentioned in lines 1 and 2 above were in conformance with regulations and rules therefore as required in the current manual of survey instructions of the United States Department of the Interior, Bureau of Land Management or by a decree of a Court of Law and/or that the corner points mentioned in lines 3, 4 and 5 above were in conformance with the rules of the Michigan Board of Land Surveyors or by a Decree of a Court of Law; established, re-established, monumented, re-monumented, recovered, found as expressed below:

**NOTE: Not more than 4 corners, all in the same town and range, may be recorded on this certificate.**

	A	B	C	D	E	F	G	H	I	J	K	L	M
2	6	5	4	3	2	1							
3													
4	7	8	9	10	11	12							
5													
6	18	17	16	15	14	13							
7													
8	19	20	21	22	23	24							
9													
10	30	29	28	27	26	25							
11													
12	31	32	33	34	35	36							
13													

A. Description of original monument and accessories and/or subsequent restoration:  
C-5

GLO - 1838 by	Rosema - 1988 per L.C.R.C.
R. Whitcomb	1/2" pipe inside 1 1/2" pipe
Set post	Nail in S. side 18" Ash - ENE. 37.60'
12" Beech - N5°W .19 ch.	Nail in S. side 12" Ash - WNW. 21.97'
8" Walnut - S43°E .21 ch.	Nail in W. side 10" Ash - SSW. 21.00'
	SW. cor. field - E. 40'; In c/l 10' creek

B. Description of corner evidence found and/or method applied in restoring or reestablishing corner:  
C-5


Found 1/2" pipe inside 1 1/2" pipe; replaced with 3/4" x 3.0' steel rod with standard remon. cap inside of 1 1/2" pipe  
Found nail in S. side 18" Ash - N80°E 37.48'  
Found nail in S. side 15" Ash - N80°W 22.00'  
Found nail in W. side 8" Ash - S18°W 20.98'  
In c/l 10' creek (S. and NW.), SW. cor. field - E. 40'

I hereby accept this corner as a correct and accurate perpetuation of the position of the original corner.

C. Description of monument for corner and accessories established to perpetuate locating the position of the corner:  
C-5

3/4" steel rod with standard remon. cap inside 1 1/2" pipe  
Set nail and remon. tag in S. side 18" Ash - N80°E 37.48'  
Set nail and remon. tag in SE. side 10" Ash - N40°E 28.34'  
Set nail and remon. tag in S. side 15" Ash - N80°W 22.00'  
Set nail and remon. tag in W. side 8" Ash - S18°W 20.98'  
Set nail and remon. tag in W. side 15" Ash - S10°E 21.26'  
In c/l of 10' creek (S. and NW.)  
SW. cor. field - E. 40'

P.A. 345 OTTAWA COUNTY  
PEER APPROVED 12/12/94  
*Harold P. Nelson*

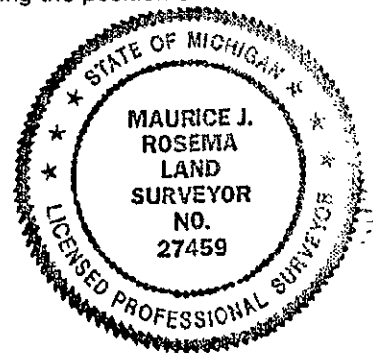

Dec. 10, 1994

Signed by *Maurice J. Rosema* Date \_\_\_\_\_  
Surveyor's Michigan License No. 27459