

SURVEY & DOCUMENTATION

Ottawa County Remonumentation

APR 05 1996

LAND CORNER RECORDATION CERTIFICATE

Filing Requirement of Act 74, Mich. P.A. 1970

For corners in

COMMISSION

Ottawa (County)

Located in:

Corner Code #

- 1. Public Land Survey T T7N R R13W
- 2. Property Controlling in Section S ___ T ___ R ___
- 3. Miscellaneous Property in Sec. S ___ T ___ R ___

C-8
(E 1/4 cor of
Section 19)
Tallmadge Twp

RECORDED

95 NOV 15 PM 2:07

Ruby L. Chubbman
REGISTER OF DEEDS
OTTAWA COUNTY, MI

Register of Deeds Stamp & File Number

- 4. Lot No. _____, Recorded Plat _____
- 5. Private Claims _____

Maurice J. Rosema, in a field survey on Dec. 31, 19 94, do hereby certify that under requirements of P.A. 74, Michigan P.A. of 1970, the corner points mentioned in lines 1 and 2 above were in conformance with regulations and rules therefore as required in the current manual of survey instructions of the United States Department of the Interior, Bureau of Land Management or by a decree of a Court of Law and/or that the corner points mentioned in lines 3, 4 and 5 above were in conformance with the rules of the Michigan Board of Land Surveyors or by a Decree of a Court of Law; established, re-established, monumented, re-monumented, recovered, found as expressed below:

	A	B	C	D	E	F	G	H	I	J	K	L	M
2	6		5		4		3		2		1		
3													
4	7		8		9		10		11		12		
5													
6	18		17		16		15		14		13		
7													
8	19		20		21		22		23		24		
9													
10	30		29		28		27		26		25		
11													
12	31		32		33		34		35		36		
13													


NOTE: Not more than 4 corners, all in the same town and range, may be recorded on this certificate.

A. Description of original monument and accessories and/or subsequent restoration:

- C-8
GLO - 1832 (Lucius Lyon D.S.)
9" Elm - N81°E 10 lks
9" Maple - N74°W 28 lks
- L.C.R.C. recorded in Liber 2, Page 147 - May 8, 1973 (over)
- L.C.R.C. recorded in Liber 5, Page 105 - Oct. 7, 1981 (over)
- L.C.R.C. recorded in Liber 6, Page 177 - Oct. 10, 1991 (over)
- L.C.R.C. recorded in Liber 5, Page 207 - April 8, 1985 (over)

B. Description of corner evidence found and/or method applied in restoring or reestablishing corner:

- C-8
Found C.I. monument
Found PK nail in top of wood post at tele. box SE 48.00
L steel fc post ENE 36.39'

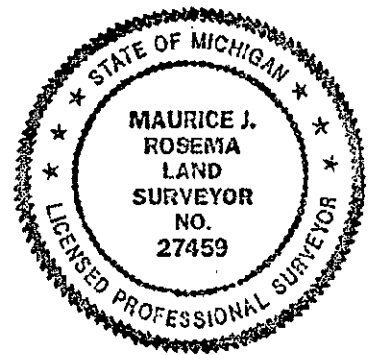

I hereby accept this corner as a correct and accurate perpetuation of the position of the original corner.

C. Description of monument for corner and accessories established to perpetuate locating the position of the corner:

- C-8
C.I. monument
Set nail and Ottawa Co. remon. tag in top of wood post at tele. box S41°E 48.02'
Set nail and Ottawa Co. remon. tag in top of wood post N74°E 36.06'
Set nail and Ottawa Co. remon. tag in NE side 7" tw Ash N29°W 9.75'
Set nail and Ottawa Co. remon. tag in E side 17" Elm (4 1/2' high) N14°W 84.93'
c/l N-S gravel road E 11'

PEER APPROVED 10/23/95

Signed by Maurice J. Rosema Date Oct. 19, 1995
Surveyor's Michigan License No. 27459

C-8 T7N, R13W

L.C.R.C. recorded in Liber 5, Page 105 - Oct. 7, 1981

T-iron	
L steel fc post	SSW 85.28'
Fc to East	ENE 36.07'
Centerline of gravel road	E 11.00'
PK in top of fc post (gate)	SE 48.13'

L.C.R.C. recorded in Liber 2, Page 147 - May 8, 1973

T-iron	
10" Sycamore	S15°W 84.60'
Gate fc post	47.77'
Steel fc post	N70°E 35.81'
Fc line to East	N 14.0'
Centerline of manhole	N45°E 182.30'

L.C.R.C. recorded in Liber 6, Page 177 - Oct. 10, 1991

C.I. monument	
Steel fc post	ENE 36.27'
PK nail in post	SE 48.34'
18" Sycamore	SSW 85.28'
8" Ash	NW 9.81'

L.C.R.C. recorded in Liber 5, Page 207 - April 8, 1985

T-iron in mon. box	
Sq spk in E side 12" Sycamore	SSW 85.28'
L fc post	ENE 36.07'
Fc to East	N 14.0'
Centerline of gravel road	E 11.0'
PK nail in top of fc post	SE 48.13'

\$ 11.00 CORNER