

SURVEY & REMONUMENTATION

APR 24 1995

Ottawa County Remonumentation
LAND CORNER RECORDATION CERTIFICATE
 Filing Requirement of Act 74, Mich. P.A. 1970

RECORDED

94 DEC 15 AM 11:53

For corners of **COMMISSION**
 Ottawa
 (County)

Located In: Corner Code #

- | | | |
|------------------------------------|--------------------------|------------|
| 1. Public Land Survey | T <u>7N</u> R <u>13W</u> | <u>C-9</u> |
| | T _____ R _____ | _____ |
| | T _____ R _____ | _____ |
| | T _____ R _____ | _____ |
| 2. Property Controlling in Section | S _____ T _____ R _____ | _____ |
| | S _____ T _____ R _____ | _____ |
| 3. Miscellaneous Property in Sec. | S _____ T _____ R _____ | _____ |

Elizabeth Kullman
 REGISTER OF DEEDS
 OTTAWA COUNTY, MI.

Register of Deeds Stamp & File Number

4. Lot No. _____, Recorded Plat _____
 5. Private Claims _____

	A	B	C	D	E	F	G	H	I	J	K	L	M
2	6		5		4		3		2		1		
3													
4	7		8		9		10		11		12		
5													
6	18		17		16		15		14		13		
7													
8	19		20		21		22		23		24		
9													
10	30		29		28		27		26		25		
11													
12	31		32		33		34		35		36		
13													

Maurice J. Rosema

I, Rosema, in a field survey on Oct. 20, 19 94, do hereby certify that under requirements of P.A. 74, Michigan P.A. of 1970, the corner points mentioned in lines 1 and 2 above were in conformance with regulations and rules therefore as required in the current manual of survey instructions of the United States Department of the Interior, Bureau of Land Management or by a decree of a Court of Law and/or that the corner points mentioned in lines 3, 4 and 5 above were in conformance with the rules of the Michigan Board of Land Surveyors or by a Decree of a Court of Law; established, re-established, monumented, re-monumented, recovered, found as expressed below:

NOTE: Not more than 4 corners, all in the same town and range, may be recorded on this certificate.

A. Description of original monument and accessories and/or subsequent restoration:

- C-9
 GLO - 1832 by Loucius Lyon D.S. 8" Sugar - S2°E .10 ch.
 Hooth - 1974 per L.C.R.C. Joiner - 1991 per L.C.R.C. rec. in L. 2, P. 603 (over) rec. in L. 6, P. 177 (over)
 14" Walnut - N25½°W .21 ch. VanKooten - 1981 per L.C.R.C. rec. in L. 5, P. 105 (over)

B. Description of corner evidence found and/or method applied in restoring or reestablishing corner:


- C-9
 Found C.I. mon. (top of mon. is at field grade)
 Found nail in S. side 5" Apple - N68°E 19.11'
 Found nail in E. side 6" Ash - N4°E 25.20'
 Found nail in N. side 5" Aspen - N89°W 59.52'
 Found nail in W. side 4" Ash - S14°E 94.10'

I hereby accept this corner as a correct and accurate perpetuation of the position of the original corner.

P.A. 345 OTTAWA COUNTY
 PEER APPROVED 12/12/94

C. Description of monument for corner and accessories established to perpetuate locating the position of the corner:

- C-9
 C.I. mon.
 Set nail and remon. tag in S. side 5" Apple - N68°E 19.11'
 Set nail and remon. tag in E. side 6" Ash - N4°E 25.20'
 Set nail and remon. tag in N. side 5" Aspen - N89°W 59.52'
 Set nail and remon. tag in W. side 4" Ash - S14°E 94.10'

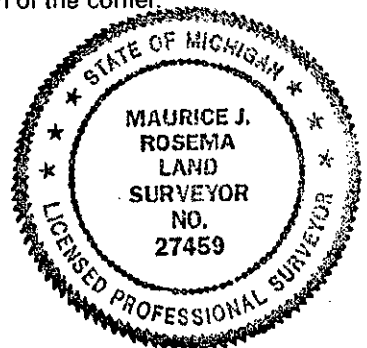

Signed by Maurice J. Rosema
 Surveyor's Michigan License No. 27459

Date Dec. 10, 1994

Part A - continued

Hooth - 1974 per L.C.R.C. rec. in L. 3, P. 603

1½" iron pipe in mon. box

9" tw. Maple - E. 29.70'

Tele. pole - N. 72.98'

VanKooten - 1981 per L.C.R.C. rec. in L. 5, P. 105

1½" pipe

Nail and tag in S. side Tele. pole - N. 73.00'

Nail and tag in S. side 9" tw. Apple - E. 29.70'

P.K. nail in N. side Power pole - ESE. 99.60'

Joiner - 1991 per L.C.R.C. rec. in L. 6, P. 177

5" tree - N. 25.17'

4" tree - W. 59.57'

5" Apple - E. 29.73'

4" Ash - S. 94.18'