

APR 05 1996 Ottawa County Remonumentation
LAND CORNER RECORDATION CERTIFICATE
COMMISSIONING Requirement of Act 74, Mich. P.A. 1970

For corners in

<u>Ottawa</u> (County)	Located In:	Corner Code #
1. Public Land Survey	T <u>T7N</u> R <u>R13W</u>	<u>C-13</u>
	T _____ R _____	<u>(SE cor of</u>
	T _____ R _____	<u>Sec. 32)</u>
	T _____ R _____	<u>Tallmadge Twp</u>
2. Property Controlling in Section	S _____ T _____ R _____	_____
	S _____ T _____ R _____	_____
3. Miscellaneous Property in Sec.	S _____ T _____ R _____	_____
	S _____ T _____ R _____	_____
4. Lot No. _____, Recorded Plat _____		
5. Private Claims _____		

RECORDED
 95 NOV 29 PM 1:46
Polykris Kestman
 REGISTER OF DEEDS
 OTTAWA COUNTY, MI

Register of Deeds Stamp & File Number

I, Maurice J. Rosema, in a field survey on Sept. 17, 19 95, do hereby certify that under requirements of P.A. 74, Michigan P.A. of 1970, the corner points mentioned in lines 1 and 2 above were in conformance with regulations and rules therefore as required in the current manual of survey instructions of the United States Department of the Interior, Bureau of Land Management or by a decree of a Court of Law and/or that the corner points mentioned in lines 3, 4 and 5 above were in conformance with the rules of the Michigan Board of Land Surveyors or by a Decree of a Court of Law; established, re-established, monumented, re-monumented, recovered, found as expressed below:

A	B	C	D	E	F	G	H	I	J	K	L	M
2	6	5	4	3	2	1						
3												
4	7	8	9	10	11	12						
5												
6	18	17	16	15	14	13						
7												
8	19	20	21	22	23	24						
9												
10	30	29	28	27	26	25						
11												
12	31	32	33	34	35	36						
13												

NOTE: Not more than 4 corners, all in the same town and range, may be recorded on this certificate.

A. Description of original monument and accessories and/or subsequent restoration:
 C-13

GLO - 1837 (Noah Brookfield D.S.)	L.C.R.C. recorded in Liber	L.C.R.C. recorded in
8" Lym N30°W 10 lks	3, Page 347 - March 3, 1979	Liber 1, Page 821
7" Sugar N57°E 25 lks	T-iron	Nov. 17, 1972
	c/l St sign post N10°W 14.2'	(over)
	c/l P pole N45°E 75.81'	
	N edge of pavement S 11.55'	
	On fc line North	

B. Description of corner evidence found and/or method applied in restoring or reestablishing corner:

C-13
 Found T-iron in mon. box, replaced with 3/4" x 2' Steel bar with Ottawa Co. remon. cap
 Found nail in S side P pole N65°E 75.58'
 N edge of pavement S 11.75'


P.A. 345 OTTAWA COUNTY
PEER APPROVED 11-20-95

I hereby accept this corner as a correct and accurate perpetuation of the position of the original corner.

Kordy P. Nedwela
DDN

C. Description of monument for corner and accessories established to perpetuate locating the position of the corner:

C-13	3/4" x 2' steel bar with Ottawa County remon. cap	N65°E 75.58'
	Set nail and Ottawa Co. remon. tag in S side P pole	N35°E 7.95'
	Set nail and Ottawa Co. remon. tag in W side P pole	N90°E 1.25'
	Centerline of street sign	N0°W 13.21'
	Set nail and Ottawa Co. remon. tag in side 6" tw tree	S0°E 11.75'
	North edge of bit. conc. pavement	

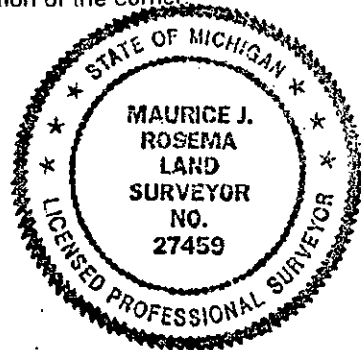

Signed by *Maurice J. Rosema* 27459
 Surveyor's Michigan License No. _____

Date Oct. 19, 1995

C-13, T7N, R13W

L.C.R.C. recorded in Liber 1, Page 821 - Nov. 17, 1972

T-iron

Edge of b.t. pavement

SSW 11.15'

SE cor. of house fndn.

WNW 232.45'

Center of street sign post

NNW 14.07'

Nail in side P pole

ENE 75.80'

Nail in side P pole

SSE 183.25'

\$ 11.00 CORNER