

FEB 24 2000

RECORDED

SECTION

Ottawa County Remonumentation  
LAND CORNER RECORDATION CERTIFICATE  
Filing Requirement of Act 74, Mich. P.A. 1970

99 OCT 27 PM 1:49

For corners in

Ottawa

(County)

Located In:

Corner Code #

- 1. Public Land Survey      T 7N R 13W      D-3  
    T    R                      N¼ corner of Section 8  
    T    R                      Tallmadge Township  
    T    R                      \_\_\_\_\_  
    T    R                      \_\_\_\_\_
- 2. Property Controlling    S \_\_\_\_\_ T \_\_\_\_\_ R \_\_\_\_\_  
    in Section                    S \_\_\_\_\_ T \_\_\_\_\_ R \_\_\_\_\_
- 3. Miscellaneous            S \_\_\_\_\_ T \_\_\_\_\_ R \_\_\_\_\_  
    Property in Sec.            S \_\_\_\_\_ T \_\_\_\_\_ R \_\_\_\_\_

*Long*  
REGISTER OF DEEDS  
OTTAWA COUNTY MI

Register of Deeds Stamp & File Number

- 4. Lot No. \_\_\_\_\_, Recorded Plat \_\_\_\_\_
- 5. Private Claims \_\_\_\_\_

I, Maurice J. Rosema, in a field survey on July 28, 1999 do hereby state that under requirements of P.A. 74, Michigan P.A. of 1970, the corner points mentioned in lines 1 and 2 above were in conformance with regulations and rules therefore as required in the current manual of survey instructions of the United States Department of the Interior, Bureau of Land Management or by a decree of a Court of Law and /or that the corner points mentioned in lines 3, 4 and 5 above were in conformance with the rules of the Michigan Board of Land Surveyors or by a Decree of a Court of Law; established, re-established, monumented, recovered, found as expressed below:

NOTE: Not more than 2 corners, all in the same town and range, may be recorded on this certificate.

	A	B	C	D	E	F	G	H	I	J	K	L	M
1													
2	6			5		4		3		2		1	
3				●									
4	7			8		9		10		11		12	
5													
6	18			17		16		15		14		13	
7													
8	19			20		21		22		23		24	
9													
10	30			29		28		27		26		25	
11													
12	31			32		33		34		35		36	
13													

A. Description of original monument and accessories and/or subsequent restoration:

- D-3  
 GLO - 1838                      LCRC per Liber 5, Page 206  
 Whitcomb D.S.                (Rosema - 1985)  
 8" Sugar -                      PK. nail in NW. side P. pole - SW. 47.34'  
    S66°E 24 links                PK. nail in E. side P. pole - NNW. 24.02'  
 6" Beech -                      SW. house foundation corner - NW. 105.24'  
    N55°W 11 links

- LCRC per Liber 4, Page 316  
 (Joiner - 1982)  
 Cast iron monument  
 Power pole - SW. 57.32'  
 Power pole - NNW. 24.05'  
 16" Maple - NW. 96.34'  
 SW. corner jog in house -  
 NW. 105.37'

B. Description of corner evidence found and/or method applied in restoring or reestablishing corner:


- D-3  
 Found Cast iron monument on centerline of E.-W. gravel road 0.5' below grade  
 Found PK. nail in NW. side Power pole - SW. 57.32'  
 Found PK. nail in E. side Power pole - NNW. 24.04'  
 Face of 18" Maple - WNW. 96.20'  
 SW. house foundation corner - NW. 105.35'

I hereby accept this corner as a correct and accurate perpetuation of the position of the original corner.

C. Description of monument for corner and accessories established to perpetuate locating the position of the corner:

- D-3  
 Cast iron monument  
 Set nail and remonumentation tag in NW. side Power pole - S40°W 57.32'  
 Set nail and remonumentation tag in E. side Power pole - N5°W 24.04'  
 Set nail and remonumentation tag in S. side 24" Maple - N57°W 95.92'  
 SW. house foundation corner - N20°W 105.35'

8/16/99  
*YDP*

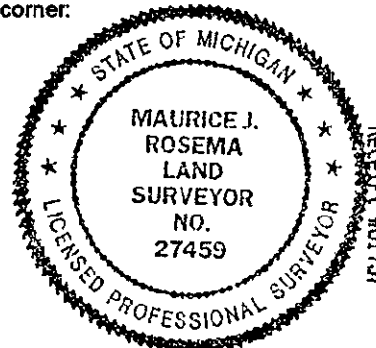

Signed by Maurice J. Rosema  
Surveyor's Michigan License No. 27459

Date August 16, 1999