

# SURVEY & REMONUMENTATION

APR 24 1995

COMMISSION

Ottawa County Remonumentation

LAND CORNER RECORDATION CERTIFICATE  
Filing Requirement of Act 74, Mich. P.A. 1970

RECORDED

94 DEC 15 AM 11:53

*D. J. ...*  
REGISTER OF DEEDS  
OTTAWA COUNTY, MI

For corners in

Ottawa (County)	Located In:	Corner Code #
1. Public Land Survey	T <u>7N</u> R <u>13W</u>	<u>D-9</u>
	T _____ R _____	_____
	T _____ R _____	_____
	T _____ R _____	_____
2. Property Controlling in Section	S _____ T _____ R _____	_____
	S _____ T _____ R _____	_____
3. Miscellaneous Property in Sec.	S _____ T _____ R _____	_____
	S _____ T _____ R _____	_____
4. Lot No. _____, Recorded Plat _____		
5. Private Claims _____		

Register of Deeds Stamp & File Number

	A	B	C	D	E	F	G	H	I	J	K	L	M
2	8		5		4		3		2		1		
3													
4	7		8		9		10		11		12		
5													
6	18		17		16		15		14		13		
7													
8	19		20		21		22		23		24		
9													
10	30		29		28		27		26		25		
11													
12	31		32		33		34		35		36		
13													

Maurice J.  
Rosema Oct. 29 94

I, \_\_\_\_\_, in a field survey on \_\_\_\_\_, 19 \_\_\_\_\_, do hereby certify that under requirements of P.A. 74, Michigan P.A. of 1970, the corner points mentioned in lines 1 and 2 above were in conformance with regulations and rules therefore as required in the current manual of survey instructions of the United States Department of the Interior, Bureau of Land Management or by a decree of a Court of Law and/or that the corner points mentioned in lines 3, 4 and 5 above were in conformance with the rules of the Michigan Board of Land Surveyors or by a Decree of a Court of Law; established, re-established, monumented, re-monumented, recovered, found as expressed below:

**NOTE: Not more than 4 corners, all in the same town and range, may be recorded on this certificate.**

A. Description of original monument and accessories and/or subsequent restoration:  
D-9

GLO - 1838 by Greer - 1973 per L.C.R.C.  
R. Whitcomb D.S. rec. in L. 2, P. 147 (over)  
10" W. Ash - S12° E .27 ch.  
24" Hickory - N33° W .45 ch. Tru-Line Surveying - 1988  
(over)

B. Description of corner evidence found and/or method applied in restoring or reestablishing corner:  
D-9


Found 1/2" rerod inside 1/2" pipe, replaced with 3/4" x 3" steel rod with std. remon. cap  
Found nail in E. side 26" Ash - N10° E 26.23'  
Found nail in N. side 15" Maple - N62° W 51.45'  
Found nail in W. side 18" Ash - S23° W 25.97'  
Found nail in W. side quad. 24" Maple - S20° E 14.94'

I hereby accept this corner as a correct and accurate perpetuation of the position of the original corner.

C. Description of monument for corner and accessories established to perpetuate locating the position of the corner:

D-9  
3/4" x 3" steel rod with std. remon. cap  
Set nail and remon. tag in E. side 26" Ash - N10° E 26.23'  
Set nail and remon. tag in N. side 15" Maple - S62° W 51.45'  
Set nail and remon. tag in W. side 18" Ash - S23° W 25.97'  
Set nail and remon. tag in W. side quad. 24" Maple - S20° E 14.94'  
Set nail and remon. tag in S. side 6" Ash - N60° W 29.97'  
Center of E.-W. ditch - S. 50' m/l  
E. edge of Grand River - W. 170' m/l

P.A. 345 OTTAWA COUNTY  
PEER APPROVED 12/12/94

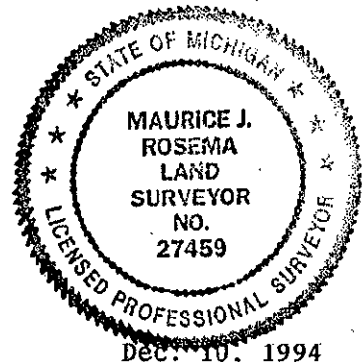

Dec. 10, 1994

Signed by *Maurice J. Rosema* Date \_\_\_\_\_  
Surveyor's Michigan License No. 27459

Part A - continued

Greer - 1973 per L.C.R.C. rec. in L. 2, P. 147

1" iron pipe with 1/2" iron next to it

16" Maple - N45°W 60.92'

14" Ash - N. 25.33'

16" quad. Maple - S15°E 14.09'

10" Maple - S60°W 50.87'

Tru-line Surveying - 1988

1/2" rerod above 1/2" iron pipe in mon. box

Nail in E. side 20" Ash - N. 26.25'

Steel fence post - N. 0.9'

Nail in N. side 12" Maple - SW. 51.48'

Nail in W. side quad. 24" Maple - SSE. 14.94'

Nail in W. side 12" Ash - SSW. 25.94'

DATE #  
OWNER #  
PAGE #  
120 #  
9 80  
2 00 #  
# 07