

APR 24 1995

COMMISSION

Ottawa County Remonumentation

RECORDED

94 DEC 15 AM 11:53

LAND CORNER RECORDATION CERTIFICATE

Filing Requirement of Act 74, Mich. P.A. 1970

R. J. ...
REGISTER OF DEEDS
OTTAWA COUNTY, MI

For corners in

Ottawa (County)	Located In:	Corner Code #
1. Public Land Survey	T <u>7N</u> R <u>13W</u>	<u>E-6</u>
	T _____ R _____	_____
	T _____ R _____	_____
	T _____ R _____	_____
2. Property Controlling in Section	S _____ T _____ R _____	_____
	S _____ T _____ R _____	_____
3. Miscellaneous Property in Sec.	S _____ T _____ R _____	_____
	S _____ T _____ R _____	_____

Register of Deeds Stamp & File Number

4. Lot No. _____, Recorded Plat _____
5. Private Claims _____

Maurice J.
Rosema

Nov. 29 94

I, _____, in a field survey on _____, 19 _____, do hereby certify that under requirements of P.A. 74, Michigan P.A. of 1970, the corner points mentioned in lines 1 and 2 above were in conformance with regulations and rules therefore as required in the current manual of survey instructions of the United States Department of the Interior, Bureau of Land Management or by a decree of a Court of Law and/or that the corner points mentioned in lines 3, 4 and 5 above were in conformance with the rules of the Michigan Board of Land Surveyors or by a Decree of a Court of Law; established, re-established, monumented, re-monumented, recovered, found as expressed below:

NOTE: Not more than 4 corners, all in the same town and range, may be recorded on this certificate.

	A	B	C	D	E	F	G	H	I	J	K	L	M
2	6	5	4	3	2	1							
3													
4	7	8	9	10	11	12							
5													
6	18	17	16	15	14	13							
7													
8	19	20	21	22	23	24							
9													
10	30	29	28	27	26	25							
11													
12	31	32	33	34	35	36							
13													

A. Description of original monument and accessories and/or subsequent restoration:
E-6

- GLO - 1838 by Nederveld - 1974 per L.C.R.C.
- R. Whitcomb D.S. rec. in L. 2, P. 667 (over)
- 12" Beech - E. .28 ch.
- 14" Sugar - S19°W .38 ch. Joiner - 1991 per L.C.R.C.
- rec. in L. 6, P. 201 (over)

B. Description of corner evidence found and/or method applied in restoring or reestablishing corner:


- E-6
- Found 1/2" iron pipe in tree root, placed std. remon. cap on it
- Found spike in NE. side 16" Beech - S60°E 0.76'
- Magnetic "pull" in W. side 30" Oak - N18°W 15.28'
- Found nail in E. side 12" Aspen - S40°W 31.74'
- Found nail in N. side 12" Oak - N65°W 23.32'

P.A. 345 OTTAWA COUNTY
PEER APPROVED 12/12/1994
Robert D. Nedderick

I hereby accept this corner as a correct and accurate perpetuation of the position of the original corner.

C. Description of monument for corner and accessories established to perpetuate locating the position of the corner:

- E-6
- 1/2" iron pipe with std. remon. cap (in tree root)
- Set nail and remon. tag in NE. side 16" Beech - S60°E 0.76'
- Set nail and remon. tag in W. side 30" Oak - N18°W 15.28'
- Set nail and remon. tag in E. side 12" Aspen - S40°W 31.75'
- Set nail and remon. tag in N. side 12" Oak - N65°W 23.32'
- Set nail and remon. tag in N. side 12" Oak - N85°E 29.70'
- Top of ravine - W. 8' and N 16'

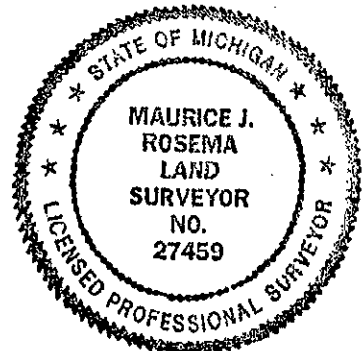

On fence lines to E. and S.
Signed by *Maurice J. Rosema* Date Dec. 10, 1994
Surveyor's Michigan License No. 27459

Part A - continued

Nederveld - 1974 per L.C.R.C. rec. in L. 2, P. 667

1/2" iron

Spike in NE. side 24" Beech - Se. 0.74'

Spike in W. side 28" Oak - NNW. 15.25'

Spike in SE. side 12" Ash - SW. 31.86'

Joiner - 1991 per L.C.R.C. rec. in L. 6, P. 201

1/2" pipe in root

Spike in NE. side 20" Beech - SE. 0.76'

Nail in W. side 26" Oak - N. 15.35'

Nail in NE. side 12" Oak - NW. 23.20'

Nail in 10" Poplar - Sw. 31.77'

1998 # 3000
