

**SURVEY &
REMONUMENTATION**

Ottawa County Remonumentation
APR 05 1996 LAND CORNER RECORDATION CERTIFICATE
COMMISSION Filing Requirement of Act 74, Mich. P.A. 1970

For corners in

<u>Ottawa</u> <small>(County)</small>	Located In:	Corner Code #
1. Public Land Survey	T <u>T7N</u> R <u>R13W</u>	<u>E-13</u>
	T _____ R _____	(SE cor of
	T _____ R _____	Sec. 32)
	T _____ R _____	<u>Tallmadge Twp</u>
2. Property Controlling in Section	S _____ T _____ R _____	_____
	S _____ T _____ R _____	_____
3. Miscellaneous Property in Sec.	S _____ T _____ R _____	_____
	S _____ T _____ R _____	_____
4. Lot No. _____, Recorded Plat _____		
5. Private Claims _____		

RECORDED
 95 NOV 29 PM 1:37
D. J. Williams
 REGISTER OF DEEDS
 OTTAWA COUNTY, MI

Register of Deeds Stamp & File Number

I, Maurice J. Rosema, in a field survey on Dec. 27, 19 94, do hereby certify that under requirements of P.A. 74, Michigan P.A. of 1970, the corner points mentioned in lines 1 and 2 above were in conformance with regulations and rules therefore as required in the current manual of survey instructions of the United States Department of the Interior, Bureau of Land Management or by a decree of a Court of Law and/or that the corner points mentioned in lines 3, 4 and 5 above were in conformance with the rules of the Michigan Board of Land Surveyors or by a Decree of a Court of Law, established, re-established, monumented, re-monumented, recovered, found as expressed below:

NOTE: Not more than 4 corners, all in the same town and range, may be recorded on this certificate.

A	B	C	D	E	F	G	H	I	J	K	L	M
2	6	5	4	3	2	1						
3												
4	7	8	9	10	11	12						
5												
6	18	17	16	15	14	13						
7												
8	19	20	21	22	23	24						
9												
10	30	29	28	27	26	25						
11												
12	31	32	33	34	35	36						
13												

A. Description of original monument and accessories and/or subsequent restoration:
 E-13

GLO - 1837 (Lucius Lyon D.S.) (Sylvester Sibley D.S.)
 7" Beech N79°E 30lks
 11" Sugar N87°W 32lks

P.A. 345 OTTAWA COUNTY

PEER APPROVED 11/20/95

L.C.R.C. recorded in Liber 5,
 Page 226 - July 25, 1985
 1" solid steel bar


Nail in N side 14" Oak WSW 35.53'
 Nail in SE side 8" Elm NE 24.41'

Nail in N side 12" Elm NW 29.13'
 Nail in NE side 16" Elm SE 8.05'
 Capped re-rod (NW cor Sec. 4, T6N, R13W) E 57.63'

B. Description of corner evidence found and/or method applied in restoring or reestablishing corner:
 E-13

Replaced 3/4" Steel rod with 3/4" X 3" Steel rod with Ottawa
 County remon. cap
 Found nail in NE side 16" Elm SE 8.04'
 Found nail in N side 12" Elm Stump NW 29.13'

I hereby accept this corner as a correct and accurate perpetuation of the position of the original corner.

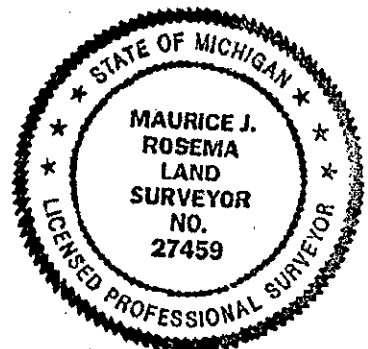

C. Description of monument for corner and accessories established to perpetuate locating the position of the corner:
 E-13

3/4" X 3" steel rod with Ottawa County remon. cap
 Set nail and Ottawa County remon. tag in top of 7" stump
 Set nail and Ottawa County remon. tag in N side 16" Elm
 Set nail and Ottawa County remon. tag in NE side 12" stump
 Set nail and Ottawa County remon. tag in S side 14" Oak

S50°W 25.32'
 S46°E 8.04'
 N59°W 29.13'
 S81°W 35.26'

Signed by *M. J. Rosema* Date October 21, 1995
 Surveyor's Michigan License No. 27459

FORM APPROVED BY MICHIGAN STATE BOARD OF LAND SURVEYORS, JAN. 26, 1971
 REVISED MAY 14, 1975
 REVISED JAN., 1983