

SURVEY & REMONUMENTATION

DEC 16 1996

COMMISSION

Ottawa County Remonumentation
LAND CORNER RECORDATION CERTIFICATE
 Filing Requirement of Act 74, Mich. P.A. 1970

For corners in
Ottawa
 (County)

	Located In:	Corner Code #
1. Public Land Survey	T <u>7N</u> R <u>13W</u>	<u>F-9</u>
	T _____ R _____	_____
	T _____ R _____	_____
	T _____ R _____	_____
2. Property Controlling in Section	S _____ T _____ R _____	_____
	S _____ T _____ R _____	_____
3. Miscellaneous Property in Sec.	S _____ T _____ R _____	_____
	S _____ T _____ R _____	_____

RECORDED


96 NOV 14 AM 11:20

Edy... [Signature]
 REGISTER OF DEEDS
 OTTAWA COUNTY, MI

Register of Deeds Stamp & File Number

4. Lot No. _____, Recorded Plat _____
 5. Private Claims _____

I, Maurice J. Rosema, in a field survey on Jan. 28, 19 96, do hereby certify that under requirements of P.A. 74, Michigan P.A. of 1970, the corner points mentioned in lines 1 and 2 above were in conformance with regulations and rules therefore as required in the current manual of survey instructions of the United States Department of the Interior, Bureau of Land Management or by a decree of a Court of Law and/or that the corner points mentioned in lines 3, 4 and 5 above were in conformance with the rules of the Michigan Board of Land Surveyors or by a Decree of a Court of Law; established, re-established, monumented, re-monumented, recovered, found as expressed below:

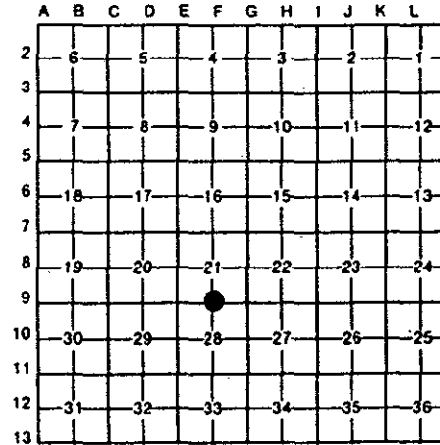

NOTE: Not more than 4 corners, all in the same town and range, may be recorded on this certificate.

A. Description of original monument and accessories and/or subsequent restoration:

F-9
 G.L.O. by R. Whitcomb in 1838
 Set post
 12" Sugar N60°E 11 lks
 30" W Oak S10°E 19 lks

L.C.R.C. rec. in Liber 5, Page 11 on Nov. 9, 1982
 T-iron
 Nail and tag in S'ly side
 16" Beech S70°W 14.03'
 Nail and tag in S'ly side
 18" Ash E 8.49'
 Spike in E'ly side 28" quad Ash N 6.63'
 Iron in on N-S fc line and on side of bank, top is 30'± N

L.C.R.C. rec. in Liber 2, Page 609 on Sept. 27, 1974
 T-iron
 30" quad Ash N 4.94'
 18" Ash E 8.45'
 14" Beech S70°W 14.01'

B. Description of corner evidence found and/or method applied in restoring or reestablishing corner:


F-9
 Found C.I. monument at grade level
 Found nail in SE side 17" Beech S72°W 14.00'
 Found nail in SE side 8" quad Ash N10°E 5.00'
 Found nail in S side 18" Ash S90°E 8.60'

P.A. 345 OTTAWA COUNTY
 PEER APPROVED 9-16-96
[Signature]

I hereby accept this corner as a correct and accurate perpetuation of the position of the original corner.

C. Description of monument for corner and accessories established to perpetuate locating the position of the corner:

F-9
 C.I. monument
 Set nail and remon tag in SE side 17" Beech S72°W 14.00'
 Set nail and remon tag in SE side 8" quad Ash N10°E 5.00'
 Set nail and remon tag in S side 18" Ash S90°E 8.60'
 Set nail and remon tag in S side 19" Beech S58°E 27.00'

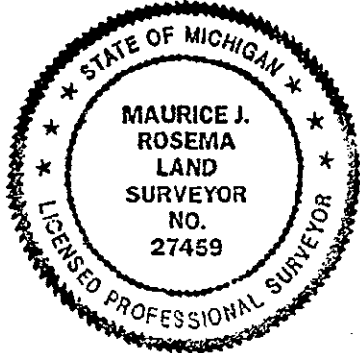

Signed by *[Signature]* Date Sept. 16, 1996
 Surveyor's Michigan License No. 27459

FORM APPROVED BY MICHIGAN STATE BOARD OF LAND SURVEYORS, JAN. 28, REVISED MAY 14, REVISED JAN. 1996