

# SURVEY & REMONUMENTATION

APR 24 1995

COMMISSION

Ottawa County Remonumentation  
**LAND CORNER RECORDATION CERTIFICATE**  
 Filing Requirement of Act 74, Mich. P.A. 1970

RECORDED

94 DEC 15 AM 11:48

*Phyllis Callman*  
 REGISTER OF DEEDS  
 OTTAWA COUNTY, MI

For corners in  
 Ottawa

(County)

Located In:

Corner Code #

- |                                    |                          |             |
|------------------------------------|--------------------------|-------------|
| 1. Public Land Survey              | T <u>7N</u> R <u>13W</u> | <u>F-11</u> |
|                                    | T _____ R _____          | _____       |
|                                    | T _____ R _____          | _____       |
|                                    | T _____ R _____          | _____       |
| 2. Property Controlling in Section | S _____ T _____ R _____  | _____       |
|                                    | S _____ T _____ R _____  | _____       |
| 3. Miscellaneous Property in Sec.  | S _____ T _____ R _____  | _____       |
|                                    | S _____ T _____ R _____  | _____       |
4. Lot No. \_\_\_\_\_, Recorded Plat \_\_\_\_\_
5. Private Claims \_\_\_\_\_

Register of Deeds Stamp & File Number

|    | A  | B  | C  | D  | E  | F  | G | H | I | J | K | L | M |
|----|----|----|----|----|----|----|---|---|---|---|---|---|---|
| 2  | 6  | 5  | 4  | 3  | 2  | 1  |   |   |   |   |   |   |   |
| 3  |    |    |    |    |    |    |   |   |   |   |   |   |   |
| 4  | 7  | 8  | 9  | 10 | 11 | 12 |   |   |   |   |   |   |   |
| 5  |    |    |    |    |    |    |   |   |   |   |   |   |   |
| 6  | 18 | 17 | 16 | 15 | 14 | 13 |   |   |   |   |   |   |   |
| 7  |    |    |    |    |    |    |   |   |   |   |   |   |   |
| 8  | 19 | 20 | 21 | 22 | 23 | 24 |   |   |   |   |   |   |   |
| 9  |    |    |    |    |    |    |   |   |   |   |   |   |   |
| 10 | 30 | 29 | 28 | 27 | 26 | 25 |   |   |   |   |   |   |   |
| 11 |    |    |    |    |    |    |   |   |   |   |   |   |   |
| 12 | 31 | 32 | 33 | 34 | 35 | 36 |   |   |   |   |   |   |   |
| 13 |    |    |    |    |    |    |   |   |   |   |   |   |   |

Maurice J. Rosema, in a field survey on Oct. 28, 1994, do hereby certify that under requirements of P.A. 74, Michigan P.A. of 1970, the corner points mentioned in lines 1 and 2 above were in conformance with regulations and rules therefore as required in the current manual of survey instructions of the United States Department of the Interior, Bureau of Land Management or by a decree of a Court of Law and/or that the corner points mentioned in lines 3, 4 and 5 above were in conformance with the rules of the Michigan Board of Land Surveyors or by a Decree of a Court of Law; established, re-established, monumented, re-monumented, recovered, found as expressed below:

**NOTE: Not more than 4 corners, all in the same town and range, may be recorded on this certificate.**

A. Description of original monument and accessories and/or subsequent restoration:

- F-11  
 GLO - 1838 by R. Whitcomb D.S. (no wit.)  
 Joiner - 1981 per L.C.R.C. rec. in L. 4, P. 258  
 C.I. mon.  
 10" Ash - E. 69.50'  
 36" Oak - SE. 38.58'  
 2" tw. Oak - SSW. 7.87'  
 Fence post - E. 1.08'

B. Description of corner evidence found and/or method applied in restoring or reestablishing corner:


- F-11  
 Found C.I. mon.  
 Found nail in W. side 38" Oak - S34°E 38.54'  
 Found nail in W. side 2" tw. Oak - S39°W 7.86'

I hereby accept this corner as a correct and accurate perpetuation of the position of the original corner.

P.A. 345 OTTAWA COUNTY  
 PEER APPROVED 12/12/94  
*Rodney D. Nedewela*

C. Description of monument for corner and accessories established to perpetuate locating the position of the corner:

- F-11  
 C.I. mon.  
 Set nail and remon. tag in W. side 38" Oak - S34°E 38.54'  
 Set nail and remon. tag in W. side 2" tw. Oak - S39°W 1.23'  
 Set nail and remon. tag in top of wood fence post - N2°E 29.31'  
 Set nail and remon. tag in top of wood fence post - S89°E 42.55'

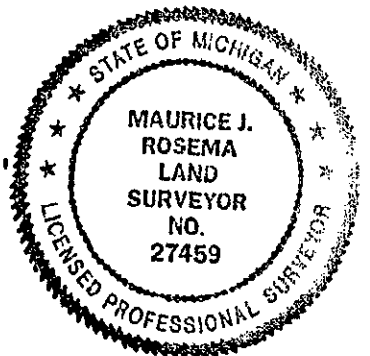

Signed by *Maurice J. Rosema*  
 Surveyor's Michigan License No. 27459

Date Dec. 10, 1994