

DEC 01 1998

SECTION

OTTAWA COUNTY REMONUMENTATION
LAND CORNER RECORDATION CERTIFICATE
Filing Requirement of Act 74, Mich. P.A. 1970

For corners in

Ottawa (County)	Located In: Georgetown Township	Corner Code #
1. Public Land Survey	T <u>7N</u> R <u>13W</u>	F-13
	T _____ R _____	S 1/4 corner
	T _____ R _____	Sec. 33
	T _____ R _____	
2. Property Controlling in Section	S _____ T _____ R _____	
	S _____ T _____ R _____	
3. Miscellaneous Property in Sec.	S _____ T _____ R _____	
	S _____ T _____ R _____	

RECORDED
98 JUL 24 PM 1:46

Ray Sublette
REGISTER OF DEEDS
OTTAWA COUNTY, MI

Register of Deeds Stamp & File Number

4. Lot No. _____, Recorded Plat _____
5. Private Claims _____

	A	B	C	D	E	F	G	H	I	J	K	L	I
2	6		5		4		3		2		1		
3													
4	7		8		9		10		11		12		
5													
6	16		17		16		15		14		13		
7													
8	19		20		21		22		23		24		
9													
10	30		29		28		27		26		25		
11													
12	31		32		33		34		35		36		
13													

I, Rodney D. Unema, in a field survey on June 19, 19 98, do hereby certify that under requirements of P.A. 74, Michigan P.A. of 1970, the corner points mentioned in lines 1 and 2 above were in conformance with regulations and rules therefore as required in the current manual of survey instructions of the United States Department of the Interior, Bureau of Land Management or by a decree of a Court of Law and/or that the corner points mentioned in lines 3, 4 and 5 above were in conformance with the rules of the Michigan Board of Land Surveyors or by a Decree of a Court of Law; established, re-established, monumented, re-monumented, recovered, found as expressed below.

NOTE: Not more than 4 corners, all in the same town and range, may be recorded on this certificate.


A. Description of original monument and accessories and/or subsequent restoration:
F-13
G.L.O. 1830 Lucius Lyon corner at 40.00 chains
Fell in pond hole
No post or bearing trees
No recorded L.C.R.C. or other information furnished

B. Description of corner evidence found and/or method applied in restoring or reestablishing corner:
F-13
No evidence of the corner was found. No fence lines or other occupation evidence was observed. Set Ottawa Co. Cap on 3/4" X 36" steel bar on Township line midway between SW corner (E-13) and SE corner (G-13) Section 33.
Accepted as a careful and faithful reestablishment of the position of the original corner.

PA. 74 OTTAWA COUNTY
PERM APPROVED 7-20-98
R.D.U.

*See reverse side for sketch

C. Description of monument for corner and accessories established to perpetuate locating the position of the corner:
F-13 S 1/4 Corner, Section 33
Ottawa Co. Cap on 3/4" X 36" Steel Bar
Set nail & O.C. tag in NW side 16" Ash N64°E 20.58'
Set nail & O.C. tag in SE side 12" Maple N80°W 42.32'
Set nail & O.C. tag in NE side 12" Ash N40°W 87.52'
F-1, T6N, R13W East 31.41'
¢ of gravel road West 155 feet

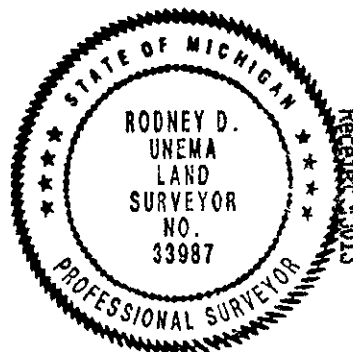

Signed by Rodney D. Unema Date June 30, 1998
Surveyor's Michigan License No. 33987

SURVEY &
REMONUMENTATION

DEC 01 1998

SECTION

G. LENGEMANN CO. N52327

