

FEB 24 2000

RECORDED

99 OCT 27 PM 1:49

Ottawa County Remonumentation
LAND CORNER RECORDATION CERTIFICATE
Filing Requirement of Act 74, Mich. P.A. 1970

Larry Sublette
REGISTER OF DEEDS
OTTAWA COUNTY MI

For corners in SECTION

Ottawa

(County)

Located in:

Corner Code #

- 1. Public Land Survey T7N R13W G-2
 T ___ R ___ W 1/4 corner, Section 3
 T ___ R ___ Tallmadge Township
 T ___ R ___ _____
- 2. Property Controlling S ___ T ___ R ___ _____
 in Section S ___ T ___ R ___ _____
- 3. Miscellaneous S ___ T ___ R ___ _____
 Property in Sec. S ___ T ___ R ___ _____

Register of Deeds Stamp & File Number

- 4. Lot No. _____, Recorded Plat _____
- 5. Private Claims _____

I, Maurice J. Rosema, in a field survey on Oct. 16, 1999 do hereby state that under requirements of P.A. 74, Michigan P.A. of 1970, the corner points mentioned in lines 1 and 2 above were in conformance with regulations and rules therefore as required in the current manual of survey instructions of the United States Department of the Interior, Bureau of Land Management or by a decree of a Court of Law and for that the corner points mentioned in lines 3, 4 and 5 above were in conformance with the rules of the Michigan Board of Land Surveyors or by a Decree of a Court of Law; established, re-established, monumented, recovered, found as expressed below:

NOTE: Not more than 2 corners, all in the same town and range, may be recorded on this certificate.

A	B	C	D	E	F	G	H	I	J	K	L	M
1												
2	6	5	4	3	2	1						
3												
4	7	8	9	10	11	12						
5												
6	18	17	16	15	14	13						
7												
8	19	20	21	22	23	24						
9												
10	30	29	28	27	26	25						
11												
12	31	32	33	34	35	36						
13												

A. Description of original monument and accessories and/or subsequent restoration:

- G-2
- GLO - 1838 LCRC per Liber 3, Page 86
- R. Whitcomb D.S. (Clapp - 1976)
- 8" A. Sugar at T-iron
- Section post 12" Maple - WSW 80.0'
- 16" Cherry - NNE 138.0'
- Fence post - S37°E 12.0'

B. Description of corner evidence found and/or method applied in restoring or reestablishing corner:


- G-2
- Found T-iron on fence line to North, replaced T-iron with 3/4" x 3' steel rod with remon. cap
- Center of 18" Ash - W 80'
- Center of 20" W. Cherry - NNE 138'
- Broken off bottom of steel fence post - SSE 12.2'

I hereby accept this corner as a correct and accurate perpetuation of the position of the original corner.

C. Description of monument for corner and accessories established to perpetuate locating the position of the corner:

- G-2
- 3/4" x 3' steel rod with remonumentation cap
- Set nail and remonumentation tag in S side 15" Maple - S74°W 22.70'
- Set nail and remonumentation tag in N side 8" Ash clump - N87°W 81.80'
- Set nail and remonumentation tag in N side 12" Maple - S85°W 59.33'
- Set nail and remonumentation tag in W side 20" W. Cherry - N5°E 138.39'
- Set nail and remonumentation tag in SW side 2" Maple - N32°W 16.98'
- On fence line to North,
- Tree row to West - S 7'

OTTAWA COUNTY
10/18/99
[Signature]

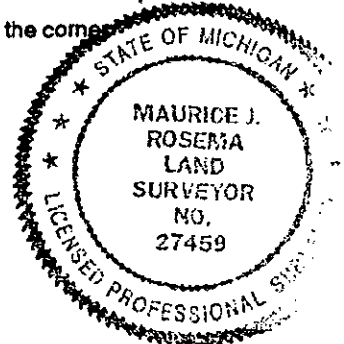

\$9.00 CORNER
Receipt #61757

Signed by *Maurice J. Rosema*
Surveyor's Michigan License No. 27459

Date October 16, 1999