

**SURVEY & REMONUMENTATION**

APR 24 1995

Ottawa County Remonumentation

RECORDED

COMMISSION

LAND CORNER RECORDATION CERTIFICATE  
Filing Requirement of Act 74, Mich. P.A. 1970

94 DEC 15 AM 11:51

For corners in

*Phyllis Kellman*  
REGISTER OF DEEDS  
OTTAWA COUNTY, MI

<u>Ottawa</u> (County)	Located In:	Corner Code #
1. Public Land Survey	T <u>7N</u> R <u>13W</u>	<u>G-4</u>
	T _____ R _____	_____
	T _____ R _____	_____
	T _____ R _____	_____
2. Property Controlling in Section	S _____ T _____ R _____	_____
	S _____ T _____ R _____	_____
3. Miscellaneous Property in Sec.	S _____ T _____ R _____	_____
	S _____ T _____ R _____	_____
4. Lot No. _____, Recorded Plat _____		
5. Private Claims _____		

Register of Deeds Stamp & File Number

A	B	C	D	E	F	G	H	I	J	K	L	M
2	6	5	4	3	2	1						
3												
4	7	8	9	10	11	12						
5												
6	18	17	16	15	14	13						
7												
8	19	20	21	22	23	24						
9												
10	30	29	28	27	26	25						
11												
12	31	32	33	34	35	36						
13												

Maurice J.

I, Rosema, in a field survey on Jan. 4, 1994, do hereby certify that under requirements of P.A. 74, Michigan P.A. of 1970, the corner points mentioned in lines 1 and 2 above were in conformance with regulations and rules therefore as required in the current manual of survey instructions of the United States Department of the Interior, Bureau of Land Management or by a decree of a Court of Law and/or that the corner points mentioned in lines 3, 4 and 5 above were in conformance with the rules of the Michigan Board of Land Surveyors or by a Decree of a Court of Law; established, re-established, monumented, re-monumented, recovered, found as expressed below:

**NOTE: Not more than 4 corners, all in the same town and range, may be recorded on this certificate.**

A. Description of original monument and accessories and/or subsequent restoration:

G-4  
GLO - 1838 signed by R. Whitcomb  
Set post 20" Red Oak - N53 W .25 ch.  
6" Beech - S23 E .10 ch.

Englert - 1976 per L.C.R.C. rec. in L. 3, P. 101 (over)  
Campbell - 1980 per L.C.R.C. rec. in L. 4, P. 74 (over)

Joiner - 1988 per L.C.R.C. rec. in L. 5, P. 327 (over)

B. Description of corner evidence found and/or method applied in restoring or reestablishing corner:

G-4  
Found C.I. mon. (top broken) in mon. box  
Found P.K. nail in NE. side Power pole - N65° W 77.49'  
Found P.K. nail in s. side wood post - S82° E 33.24'


P.A. 345 OTTAWA COUNTY  
PEER APPROVED 4/18/94

*Murray D. Nedewold*

I hereby accept this corner as a correct and accurate perpetuation of the position of the original corner.

C. Description of monument for corner and accessories established to perpetuate locating the position of the corner:

G-4  
C.I. mon. in mon. box  
Set nail and remon. tag in N. side 14" Elm - N65° W 77.49'  
Set nail and remon. tag in N. side 15" Elm - S80° W 34.69'  
Set nail and remon. tag in NE. side Power pole - N25° W 77.49'  
Set nail and remon. tag in S. side wood post - S82° E 33.24  
Set nail and remon. tag in SW. side 10" Maple - S25° E 106.17'  
On centerline of N.-S. bit. conc. road

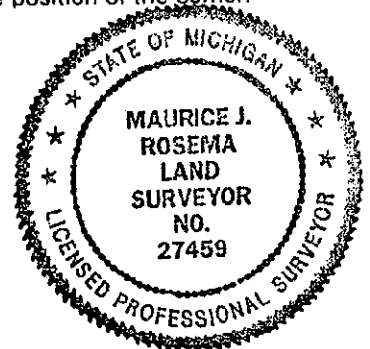

Signed by *Maurice J. Rosema* Date April 18, 1994  
Surveyor's Michigan License No. 27459

Part A - continued

Englert - 1976 per L.C.R.C. rec. in L. 3, P. 101

1" bar in mon. box

Power pole - WNW. 77.42'

Tele. pole - E. 33.09'

Tele. pole - SE. 38.40'

Campbell - 1980 per L.C.R.C. rec. in L. 4, P. 74

1" bar in mon. box

Tele. pole - E. 33.09'

Tele. pole - SE. 38.40'

Power pole - WNW. 77.42'

Joiner - 1988 per L.C.R.C. rec. in L. 5, P. 327

C.I. mon.

Tele. pole - WNW. 34.09'

Tele. pole - ESE. 38.31'

Tri. 4" tree - E. 36.81'

6" tree - WSW. 34.69'

DATE #  
COUNT  
DATE #  
F030