

SURVEY & REMONUMENTATION

Ottawa County Remonumentation

APR 24 1995

LAND CORNER RECORDATION CERTIFICATE
Filing Requirement of Act 74, Mich. P.A. 1970

RECORDED

94 DEC 15 AM 11:51

COMMISSION

D. J. ...
REGISTER OF DEEDS
OTTAWA COUNTY, MI

For corners in

<u>Ottawa</u> (County)	Located In:	Corner Code #
1. Public Land Survey	T <u>7N</u> R <u>13W</u>	<u>G-5</u>
	T _____ R _____	_____
	T _____ R _____	_____
	T _____ R _____	_____
2. Property Controlling in Section	S _____ T _____ R _____	_____
	S _____ T _____ R _____	_____
3. Miscellaneous Property in Sec.	S _____ T _____ R _____	_____
	S _____ T _____ R _____	_____

Register of Deeds Stamp & File Number

4. Lot No. _____, Recorded Plat _____
5. Private Claims _____

Maurice J. Rosema

Jan. 4 94

I, _____, in a field survey on _____, 19____, do hereby certify that under requirements of P.A. 74, Michigan P.A. of 1970, the corner points mentioned in lines 1 and 2 above were in conformance with regulations and rules therofore as required in the current manual of survey instructions of the United States Department of the Interior, Bureau of Land Management or by a decree of a Court of Law and/or that the corner points mentioned in lines 3, 4 and 5 above were in conformance with the rules of the Michigan Board of Land Surveyors or by a Decree of a Court of Law; established, re-established, monumented, re-monumented, recovered, found as expressed below:

NOTE: Not more than 4 corners, all in the same town and range, may be recorded on this certificate.

A. Description of original monument and accessories and/or subsequent restoration:
G-5

- GLO - 1838 by VanKooten - 1972 per L.C.R.C. rec. in L. 1, P. 765 (over)
- R. Whitcomb Campbell - 1980 per L.C.R.C. rec. in L. 4, P. 74 (over)
- 30" Beech - N83° E .25 ch. Joiner - 1984 per L.C.R.C. rec. in L. 5, P. 185 (over)
- 8" Sugar - N72° W .21 ch.

B. Description of corner evidence found and/or method applied in restoring or reestablishing corner:
G-5


- Found C.I. mon. in mon. box
- Centerline of Street sign post - S55° E 51.80'
- Found P.K. nail in SE. side Power pole - S32° W 80.04'
- Found spike in N. side 18" Ash - N89° W 55.27'

F.A. 345 OTTAWA COUNTY
PEER APPROVED 4/18/94

I hereby accept this corner as a correct and accurate perpetuation of the position of the original corner.

C. Description of monument for corner and accessories established to perpetuate locating the position of the corner:
G-5

- C.I. mon. in mon. box
- Set nail and remon. tag in NW. side Power pole - S32° W 80.00'
- Set chisled "x" cut in top of conc. culvert - N66° E 43.99'
- Set nail and remon. tag in N. side 18" Ash - N89° W 55.27'
- NE. cor. conc. stoop (bottom step) - N52° W 103.86
- On centerline of gravel road to E.
- Centerline of N.-S. bit. conc. road - W. 0.5'

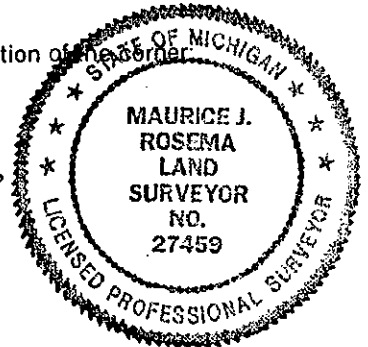

April 18, 1994

Signed by *M. J. Rosema* Date _____
Surveyor's Michigan License No. 27459

Part A - continued

VanKooten - 1972 per L.C.R.C. rec. in L. 1, P. 165

T-iron

Nail in side T. pole - NE. 45.05'

Sq. spike in side 22' Box Elder - WSW. 34.47'

Nail in side Power pole - SW. 79.98'

Campbell - 1980 per L.C.R.C. rec. in L. 4, P. 74

Iron in mon. box

16' Ash - W. 55.31'

C.B. - NW. 34.12'

Tele. Ped. - NE. 54.9'

Street sign - SE. 51.6'

Joiner - 1984 per L.C.R.C. rec. in L. 5, P. 185

C.I. mon.

Power pole - - SSW. 80.00'

14" Ash - W. 55.30'

30" Willow - NW. 120.50'

12" Box Elder - ESE. 106.42'

Street sign - SE. 51.80'

CODE #
CONTRACT
DATE #
HSSR

120 #
9.00
DATE #