

SURVEY & REMONUMENTATION

APR 24 1995

Ottawa County Remonumentation

LAND CORNER RECORDATION CERTIFICATE

Filing Requirement of Act 74, Mich. P.A. 1970

RECORDED

94 DEC 15 AM 11:53

COMMISSION

For corners in
Ottawa

Dorothy L. Hollman
REGISTER OF DEEDS
OTTAWA COUNTY, MI

(County)	Located In:	Corner Code #:
1. Public Land Survey	T <u>7N</u> R <u>13W</u>	<u>G-10</u>
	T _____ R _____	_____
	T _____ R _____	_____
	T _____ R _____	_____
2. Property Controlling in Section	S _____ T _____ R _____	_____
	S _____ T _____ R _____	_____
3. Miscellaneous Property in Sec.	S _____ T _____ R _____	_____
	S _____ T _____ R _____	_____

Register of Deeds Stamp & File Number

4. Lot No. _____, Recorded Plat _____
5. Private Claims _____

	A	B	C	D	E	F	G	H	I	J	K	L	M
2	6	5	4	3	2	1							
3													
4	7	8	9	10	11	12							
5													
6	18	17	16	15	14	13							
7													
8	19	20	21	22	23	24							
9													
10	30	29	28	27	26	25							
11													
12	31	32	33	34	35	36							
13													

Maurice J.

Rosema

I, Rosema, in a field survey on Oct. 26, 19 94, do hereby certify that under requirements of P.A. 74, Michigan P.A. of 1970, the corner points mentioned in lines 1 and 2 above were in conformance with regulations and rules therefore as required in the current manual of survey instructions of the United States Department of the Interior, Bureau of Land Management or by a decree of a Court of Law and/or that the corner points mentioned in lines 3, 4 and 5 above were in conformance with the rules of the Michigan Board of Land Surveyors or by a Decree of a Court of Law; established, re-established, monumented, re-monumented, recovered, found as expressed below:

NOTE: Not more than 4 corners, all in the same town and range, may be recorded on this certificate.

A. Description of original monument and accessories and/or subsequent restoration:

G-10

GLO - 1838 by

R. Whitcomb D.S.

8" Beech - N22°E .19 ch.

15" Walnut - S8°W .24 ch.

Chambers - 1971 per L.C.R.C. rec. in L. 1, P. 213 (over)

Joiner - 1981 per L.C.R.C. rec. in L. 4, P. 209 (over)

Spicer - 1974 per L.C.R.C. rec. in L. 2, P. 465 (over)

Rosema - 1985 per L.C.R.C. rec. in L. 5, P. 233 (over)

Joiner 1988 per L.C.R.C. rec. in L. 5, P. 331 (over)

B. Description of corner evidence found and/or method applied in restoring or reestablishing corner:

G-10

Found C.I. mon 0.6' below grade

Found P.K. nail and tag in E. side Power pole - N2°E 37.92'

Found nail in W. side 8" Elm - S4°W 78.94'

I hereby accept this corner as a correct and accurate perpetuation of the position of the original corner.

P.A. 345 OTTAWA COUNTY
PEER APPROVED 12/12/94

Harold D. Peterson

C. Description of monument for corner and accessories established to perpetuate locating the position of the corner:

G-10

C.I. mon.


Set nail and remon. tag in E. side Power pole - N2°E 37.92'

Set nail and remon. tag in E. side mail box post - S3°E 18.00'

Set nail and remon. tag in W. side 8" Elm - S4°W 78.94'

Set nail and remon. tag in W. side 7" tree - S72°W 163.30'

Centerline of E.-W. gravel road - S. 5'±

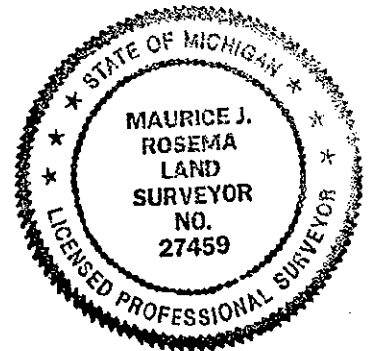

Signed by

Maurice J. Rosema

Date

Dec. 10, 1994

Surveyor's Michigan License No.

27459

Part A - continued

Chambers - 1971 per L.C.R.C. in L. 1, P. 213

T-iron

C.P. pole - N0°E 38.00'

4" Elm - N81°E 83.88'

M.B.T. pole - S43°E 33.0'

Centerline road - S. 4'

Spicer - 1974 per L.C.R.C. rec. in L. 2, P. 465

T-iron

Face of Power pole - N. 38.00'

Face of gate post - S45°E 33.10'

Centerline of 3" C. Elm - N80°E 83.70'

Centerline of road - S. 5'

Joiner - 1981 per L.C.R.C. rec. in L. 4, P. 209

C.I. mon.

Power pole - N. 38.17'

Fence post - SE. 69.66'

5" tree - S. 78.59'

E. end corr. culv. - SE. 45.16'

Rosema - 1985 per L.C.R.C. rec. in L. 5, P. 233

C.I. mon. in mon. box

Nail in W. side 6" Elm - S. 78.84'

P.K. nail in E. side Power pole - N. 38.04'

Conc spike in N. side 6" Locust - WSW. 137.36

Joiner - 1988 per L.C.R.C. rec. in L. 5, P. 331

C.I. mon.

12" Cherry - WNW. 26.26'

8" Ash - NW. 44.62'

18" Elm - NE. 47.42'

CONF #
CORNER
CODE #
1988