

**SURVEY & REMONUMENTATION**

APR 24 1995

COMMISSION

Ottawa County Remonumentation  
**LAND CORNER RECORDATION CERTIFICATE**  
 Filing Requirement of Act 74, Mich. P.A. 1970

RECORDED  
 94 DEC 15 AM 11:53

*Deborah S. Williams*  
 REGISTER OF DEEDS  
 OTTAWA COUNTY, MI

For corners in

Ottawa <small>(County)</small>	Located In:	Corner Code #
1. Public Land Survey	T <u>7N</u> R <u>13W</u>	<u>G-11</u>
	T _____ R _____	_____
	T _____ R _____	_____
	T _____ R _____	_____
2. Property Controlling in Section	S _____ T _____ R _____	_____
	S _____ T _____ R _____	_____
3. Miscellaneous Property in Sec.	S _____ T _____ R _____	_____
	S _____ T _____ R _____	_____
4. Lot No. _____, Recorded Plat _____		
5. Private Claims _____		

Register of Deeds Stamp & File Number

	A	B	C	D	E	F	G	H	I	J	K	L	M
2	6	5	4	3	2	1							
3													
4	7	8	9	10	11	12							
5													
6	18	17	16	15	14	13							
7													
8	19	20	21	22	23	24							
9													
10	30	29	28	27	26	25							
11													
12	31	32	33	34	35	36							
13													

Maurice J. Rosema, in a field survey on Oct. 28, 19 94, do hereby certify that under requirements of P.A. 74, Michigan P.A. of 1970, the corner points mentioned in lines 1 and 2 above were in conformance with regulations and rules therefore as required in the current manual of survey instructions of the United States Department of the Interior, Bureau of Land Management or by a decree of a Court of Law and/or that the corner points mentioned in lines 3, 4 and 5 above were in conformance with the rules of the Michigan Board of Land Surveyors or by a Decree of a Court of Law; established, re-established, monumented, re-monumented, recovered, found as expressed below:

**NOTE: Not more than 4 corners, all in the same town and range, may be recorded on this certificate.**

A. Description of original monument and accessories and/or subsequent restoration:

G-11  
 GLO - 1838 by Bonnema - 1977 per L.C.R.C.  
 R. Whitcomb D.S. rec. in L. 3, P. 166 (over)  
 26" Lym. - S80°E .5 ch.  
 26" Sugar - S84°W .20 ch. Joiner - 1991 per L.C.R.C.  
 rec. in L. 6, P. 194

B. Description of corner evidence found and/or method applied in restoring or reestablishing corner:


G-11  
 Found C.I. mon.  
 Found nail in NW. side 14" Beech - N60°W 8.70'  
 Found nail in S. side 20" Ash - N63°E 3.05'  
 Found nail in SW. side 16" Ash - SE. 2.90'  
 Found nail in S. side 6" (dead) Maple - S89°E 7.68'

I hereby accept this corner as a correct and accurate perpetuation of the position of the original corner.

P.A. 345 OTTAWA COUNTY  
 PEER APPROVED 12/12/94  
*Deborah D. Medewell*

C. Description of monument for corner and accessories established to perpetuate locating the position of the corner:

G-11  
 C.I. mon.  
 Set nail and remon. tag in NW. side 14" Beech - N60°W 8.70'  
 Set nail and remon. tag in S. side 20" Beech - N63°E 3.05'  
 Set nail and remon. tag in SW. side 16" Ash - S49°E 2.90'  
 Set nail and remon. tag in S. side 6" (dead) Maple - S89°E 7.68'

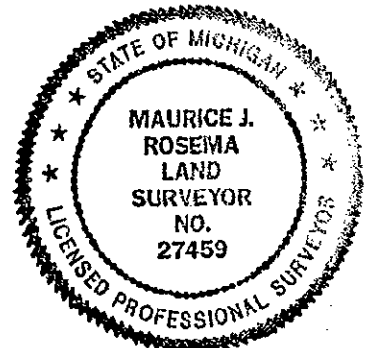

Signed by *Maurice J. Rosema*  
 Surveyor's Michigan License No. 27459

Date Dec. 10, 1994

Part A - continued

Bonnema - 1977 per L.C.R.C. rec. in L. 3, P. 166

3/4" iron

Nail in side 14" Beech - WNW. 8.80'

Nail in side 16" Ash - SE. 2.82'

Nail in side 6" Maple - E. 7.62'

Nail in side 20" Ash - NE. 3.04'

Joiner - 1991 per L.C.R.C. rec. in L. 6, P. 194

C.I. mon.

16" Ash - SE. 2.89'

20" Ash - NE. 3.05'

14" Beech - WNW. 8.74'

6" Maple - E. 7.62'

1991  
150  
9.04  
124