

SURVEY & REMONUMENTATION

APR 24 1995

COMMISSION

Ottawa County remonumentation
LAND CORNER RECORDATION CERTIFICATE
 Filing Requirement of Act 74, Mich. P.A. 1970

RECORDED

94 DEC 15 AM 11:49

Phyllis Kellerman
 REGISTER OF DEEDS
 OTTAWA COUNTY, MI

For corners in

Ottawa (County)	Located In:	Corner Code #
1. Public Land Survey	T <u>7N</u> R <u>13W</u>	<u>H-3</u>
	T _____ R _____	_____
	T _____ R _____	_____
	T _____ R _____	_____
2. Property Controlling in Section	S _____ T _____ R _____	_____
	S _____ T _____ R _____	_____
3. Miscellaneous Property in Sec.	S _____ T _____ R _____	_____
	S _____ T _____ R _____	_____

Register of Deeds Stamp & File Number

4. Lot No. _____, Recorded Plat _____
 5. Private Claims _____

	A	B	C	D	E	F	G	H	I	J	K	L	M
2	6	5	4	3	2	1							
3													
4	7	8	9	10	11	12							
5													
6	18	17	16	15	14	13							
7													
8	19	20	21	22	23	24							
9													
10	30	29	28	27	26	25							
11													
12	31	32	33	34	35	36							
13													

I, Maurice J. Rosema in a field survey on Jan. 3, 19 94 do hereby certify that under requirements of P.A. 74, Michigan P.A. of 1970, the corner points mentioned in lines 1 and 2 above were in conformance with regulations and rules therefore as required in the current manual of survey instructions of the United States Department of the Interior, Bureau of Land Management or by a decree of a Court of Law and/or that the corner points mentioned in lines 3, 4 and 5 above were in conformance with the rules of the Michigan Board of Land Surveyors or by a Decree of a Court of Law; established, re-established, monumented, re-monumented, recovered, found as expressed below:

NOTE: Not more than 4 corners, all in the same town and range, may be recorded on this certificate.

- A. Description of original monument and accessories and/or subsequent restoration:
- | | | |
|--|---|--|
| H-3 Nederveld - 1974 per L.C.R.C.
recorded in L. 3, P. 669
Iron
P. pole - S. 32.16'
P.K. in fc. post - N. 33.41'
P.K. in RR. tie (fc. post) - NW. 67.05 | Campbell - 1980 per L.C.R.C.
recorded in L. 4, P. 75
T-iron
P. pole - S. 32.16'
Fc. post - N. 33.41'
Fc. post - NW. 67.05' | Joiner - 1981 per L.C.R.C. recorded in 4, P. 246
C.I.M.
Tele. pole - N. 101.8
Apple tree - SE. 82.6
M.B.T. Ped. - SSW. 57.18'
Apple tree - SW. 81.78' |
|--|---|--|

B. Description of corner evidence found and/or method applied in restoring or reestablishing corner:

H-3
 Found C.I. mon. in mon. box
 Found spike and tag in E. side 15" Apple - S45°W 81.68

G.L.O. - 1838 signed by R. Whitcomb
 D.S.
 no cor. set


I hereby accept this corner as a correct and accurate perpetuation of the position of the corners.

P.A. 345 OTTAWA COUNTY
 PEER APPROVED 4/18/94

Murray D. Nederveld

C. Description of monument for corner and accessories established to perpetuate locating the position of the corner:

H-3
 C.I. mon. in mon. box
 Set nail and remon. tag in E. side P. pole - N1°W 101.92'
 Set nail and remon. tag in NE. side 15" Apple - S15°E 66.55'
 Set nail and remon. tag in N. side 15" Apple - S20°W 65.28'
 Set nail and remon. tag in E. side 15" Apple - S45°W 81.68'

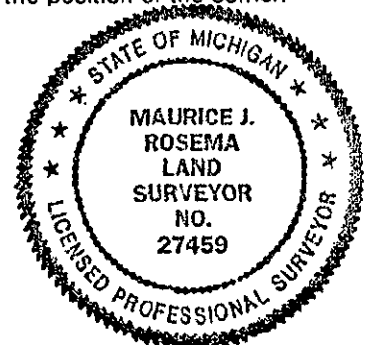

Signed by Maurice J. Rosema
 Surveyor's Michigan License No. 27459

Date April 18, 1994

FORM APPROVED BY MICHIGAN STATE BOARD OF LAND SURVEYORS, JAN. 28, 1971
 REVISED MAY 14, 1975
 REVISED JAN., 1983