

SURVEY & REMONUMENTATION

APR 24 1995

COMMISSION

Ottawa County remonumentation

LAND CORNER RECORDATION CERTIFICATE

Filing Requirement of Act 74, Mich. P.A. 1970

RECORDED

94 DEC 15 AM 11:49

Phyllis Callman
REGISTER OF DEEDS
OTTAWA COUNTY, MI

For corners in

Ottawa

(County)

Located In:

Corner Code #

- | | | |
|---------------------------------------|--------------------------|------------|
| 1. Public Land Survey | T <u>7N</u> R <u>13W</u> | <u>H-5</u> |
| | T _____ R _____ | _____ |
| | T _____ R _____ | _____ |
| | T _____ R _____ | _____ |
| 2. Property Controlling in Section | S _____ T _____ R _____ | _____ |
| | S _____ T _____ R _____ | _____ |
| 3. Miscellaneous Property in Sec. | S _____ T _____ R _____ | _____ |
| | S _____ T _____ R _____ | _____ |
| 4. Lot No. _____, Recorded Plat _____ | | |
| 5. Private Claims _____ | | |

Register of Deeds Stamp & File Number

	A	B	C	D	E	F	G	H	I	J	K	L	M
2	6	5	4	3	2	1							
3													
4	7	8	9	10	11	12							
5													
6	18	17	16	15	14	13							
7													
8	19	20	21	22	23	24							
9													
10	30	29	28	27	26	25							
11													
12	31	32	33	34	35	36							
13													

I, Maurice J. Rosema, in a field survey on Jan. 2, 1994, do hereby certify that under requirements of P.A. 74, Michigan P.A. of 1970, the corner points mentioned in lines 1 and 2 above were in conformance with regulations and rules therefore as required in the current manual of survey instructions of the United States Department of the Interior, Bureau of Land Management or by a decree of a Court of Law and/or that the corner points mentioned in lines 3, 4 and 5 above were in conformance with the rules of the Michigan Board of Land Surveyors or by a Decree of a Court of Law; established, re-established, monumented, re-monumented, recovered, found as expressed below:

NOTE: Not more than 4 corners, all in the same town and range, may be recorded on this certificate.

A. Description of original monument and accessories and/or subsequent restoration:

- | | | | |
|-----|----------------------------------------------------|--------------------------------------------------|-------------------------------------------------|
| H-5 | VanKooten - 1973 per L.C.R.C. rec. in L. 2, P. 323 | Campbell - 1980 per L.C.R.C. rec. in L. 4, P. 75 | Joiner - 1984 per L.C.R.C. rec. in L. 5, P. 191 |
| | 1" iron | 1" iron | C.I. mon. |
| | Nail in P. pole - SSE. 72.85' | 30" Walnut - SE. 47.53' | 18" Ash - NNE. 41.00' |
| | Nail in 30" Walnut - SE. 47.53' | 12" Maple - S75°W 77.22' | 30" Walnut - SE. 47.39' |
| | Nail in 12" Maple - WSW. 77.22' | 18" Ash - N20°E 40.77' | 12" Maple - WSW. 77.35' |
| | Nail in 18" Ash - NNE. 40.77' | T. pole - N25°E 22.30' | P. pole - SSE. 72.45' |
| | Nail in T. pole - NNE. 22.30' | | |

B. Description of corner evidence found and/or method applied in restoring or reestablishing corner:


- | | | |
|-----|---------------------------------------------------|------------------------------------------|
| H-5 | Found C.I. mon. (top broken) 0.1' | G.L.O. - 1838 signed by R. Whitcomb D.S. |
| | below gravel road surface | 10" Sugar - N84°E .29 ch. |
| | Found spike in NE. side 30" Walnut - S44°E 46.97' | 8" Beech - S87°W .27 ch. |
| | Found P.K. nail in W. side P. pole - S10°E 72.20' | |
| | Found spike in N. side 16" Maple - S71°W 77.65' | |

I hereby accept this corner as a correct and accurate perpetuation of the position of the original corner.

P.A. 345 OTTAWA COUNTY
PEER APPROVED 4/18/94
Murray P. Hedrick

C. Description of monument for corner and accessories established to perpetuate locating the position of the corner:

- H-5
- Set nail and remon. tag in NE side 30" Walnut - S44°E 46.97'
 - Set nail and remon. tag in W. side P. pole - S10°E 72.20'
 - Set nail and remon. tag in W. side 26" Ash - N8°E 40.77'
 - Set nail and remon. tag in N. side 16" Maple - S71°W 77.65'

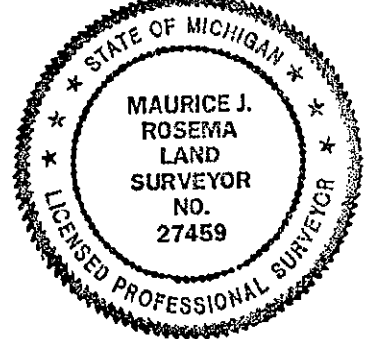

Signed by Maurice J. Rosema
Surveyor's Michigan License No. 27459

Date April 18, 1994