FEB 24 2000

SECTION

RECORDED

99 SEP 23 PM 3: 20

REGISTER OF DEEDS
OTTAWA COUNTY, MI

Seg. 2

OTTAWA COUNTY REMONUMENTATION

LAND CORNER RECORDATION CERTIFICATE
Filing Requirement of Act 74, Mich. P.A. 1970

For corners in OTTAWA (County)

	Located In:	Corner Code #
1. Public Land Survey	T 7N R 13W	H-5, N 1/4 Corner,
	T___ R___	Section 15,
	T___ R___	Tallmadge Twp
	T___ R___	
2. Property Controlling	S___ T___ R___	
in Section	S___ T___ R___	
3. Miscellaneous	S___ T___ R___	
Property in Sec.	S___ T___ R___	

Register of Deeds Stamp & File Number

4. Lot No. _____ , Recorded Plat _____
5. Private Claims _____

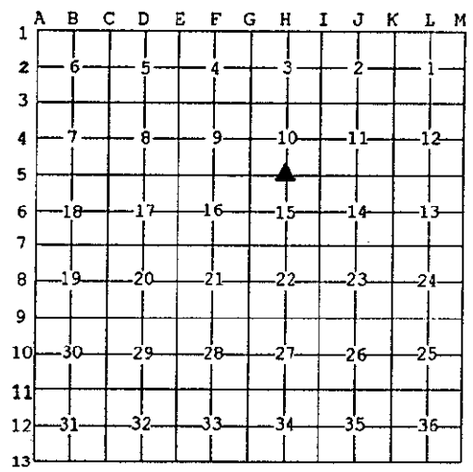

I, Randal J. Vugteveen, in a field survey on August 25, 19 99 do hereby state that under requirements of P.A. 74, Michigan P.A. of 1970, the corner points mentioned in lines 1 and 2 above were in conformance with regulations and rules therefore as required in the current manual of survey instructions of the United States Department of the Interior, Bureau of Land Management or by a decree of a Court of Law and /or that the corner points mentioned in lines 3, 4 and 5 above were in conformance with the rules of the Michigan Board of Land Surveyors or by a Decree of a Court of Law; established, re-established, monumented, recovered, found as expressed below:

NOTE: Not more than 2 corners, all in the same town and range, may be recorded on this certificate.

A. Description of original monument and accessories and/or subsequent restoration:

H-5 Ottawa County Remonumentation Certificate Liber 2, Page 263
Rosema 1994
Found C.I,Mmon. (top broken)
Nail & Remon Tag NE side 30" Walnut S44°E 46.97'
Nail & Remon Tag W side power pole S10°E 72.20'
Nail & Remon Tag W side 26" Ash N8°E 40.77'
Nail & Remon Tag N side 16" Maple S71°W 77.65'

9/13/99
GDN

B. Description of corner evidence found and/or method applied in restoring or reestablishing corner:

H-5 June 3, 1999 set rebar at intersection of witnesses (the four above)

Found MVK cap 0.35' North and 0.2' West (Ottawa County Road Commission is re-building the road at this time)

Accepted set rebar as a careful and faithful reestablishment of the position of the original corner. Set Witness Iron Control outside of construction (Witnessing set Rebar)

August 25, 1999 Recovered Witness Irons and set 3/4" X 24" Iron Bar with Remonumentation Cap.

C. Description of monument for corner and accessories established to perpetuate locating the position of the corner:

H-5 3/4" X 24" Iron Bar with Remonumentation Cap

Found Nail and Remon Tag in NE side 30" Walnut S44°E 46.95'
Found Nail and Remon Tag in W side power pole S10°W 72.18'
Found Nail and Remon Tag in W side 26" Ash N8°E 40.78'
Set Nail and Remon Tag on NE side 4" Maple N55°W 47.14'
On centerline (new) E & W gravel road (to be paved soon)

$1.00 PHOTO
Receipt #58324
$9.00 CORNER
Receipt #58324

Signed by Randal J. Vugteveen

Surveyor's Michigan License No. 28429

Date 9/12/99

FORM APPROVED BY MICHIGAN STATE BOARD OF PROFESSIONAL SURVEYORS, JAN. 28, 1971
REVISED MAY 14,1975
REVISED JAN., 1983
REVISED OCT., 1995