

FEB 24 2000

SECTION

Ottawa County Remonumentation
LAND CORNER RECORDATION CERTIFICATE
Filing Requirement of Act 74, Mich. P.A. 1970

RECORDED

99 DEC -2 PM 1:12

Dany S. Rosema
REGISTER OF DEEDS
OTTAWA COUNTY, MI

For corners in

Ottawa
(County)

Located In:

Corner Code #

- 1. Public Land Survey T7N R13W H-9
 T ___ R ___ N 1/4 corner, Section 27
 T ___ R ___ Tallmadge Township
 T ___ R ___
- 2. Property Controlling S ___ T ___ R ___
 in Section S ___ T ___ R ___
- 3. Miscellaneous S ___ T ___ R ___
 Property in Sec. S ___ T ___ R ___

Register of Deeds Stamp & File Number

- 4. Lot No. _____, Recorded Plat _____
- 5. Private Claims _____

I, Maurice J. Rosema, in a field survey on Sept. 9, 1999 do hereby state that under requirements of P.A. 74, Michigan P.A. of 1970, the corner points mentioned in lines 1 and 2 above were in conformance with regulations and rules therefore as required in the current manual of survey instructions of the United States Department of the Interior, Bureau of Land Management or by a decree of a Court of Law and /or that the corner points mentioned in lines 3, 4 and 5 above were in conformance with the rules of the Michigan Board of Land Surveyors or by a Decree of a Court of Law; established, re-established, monumented, recovered, found as expressed below:

NOTE: Not more than 2 corners, all in the same town and range, may be recorded on this certificate.

A	B	C	D	E	F	G	H	I	J	K	L	M
1												
2	6	5	4	3	2	1						
3												
4	7	8	9	10	11	12						
5												
6	18	17	16	15	14	13						
7												
8	19	20	21	22	23	24						
9												
10	30	29	28	27	26	25						
11												
12	31	32	33	34	35	36						
13												

A. Description of original monument and accessories and/or subsequent restoration:

- H-9
- GLO - 1838 LCRC per Liber 2, Page 487
- R. Whitcomb D.S. (Clapp - 1974)
- Set post 1 1/2" iron pipe
- 30" W. Oak - S53°W c/l pavement - S. 27.70'
- 28 links MBT pole - W. 67.10'
- 18" Beech - N71°E
- 24 links

From the files of Tru-Line Surveying P.C.
1/2" re-rod
Nail in E. side 12" Oak - NNW. 37.59'
Nail in E. side 4" Oak - NW. 47.10'
Nail in W. side 8" Oak - N. 27.52'
Centerline M-45 (painted double yellow lines - S. 28.0')

NOTE: THIS L.C.R.C. IS INTENDED TO REPLACE THE L.C.R.C. AS RECORDED IN LIBER 4, PAGE 453 (TO CORRECT TYPO ON SECTION NUMBER)

B. Description of corner evidence found and/or method applied in restoring or reestablishing corner:


- H-9
- Found capped MVK re-rod, replaced with 3/4" x 3" steel rod with remonumentation cap
- Found nail in E. side 15" Oak - N30°W 37.50'
- Found nail in W. side 6" Oak - N50°W 47.00'
- On tree row to S.

MAURICE J. ROSEMA
REGISTERED PROFESSIONAL SURVEYOR
9/13/99

I hereby accept this corner as a correct and accurate perpetuation of the position of the original corner.

C. Description of monument for corner and accessories established to perpetuate locating the position of the corner:

- H-9
- 3/4" x 3" steel rod with remonumentation cap
- Set nail and remonumentation tag in E. side 15" Oak - N30°W 37.28'
- Set nail and remonumentation tag in E. side 12" Oak - N14°E 47.59'
- Set nail and remonumentation tag in E. side twin 6" Oak - N50°W 47.67'
- Set nail and remonumentation tag in E. side guy pole - N0°W 24.22'
- Set nail and remonumentation tag in E. side Power pole - S0°E 90.15'
- North edge of bit. conc. (M-45) - S. 2'

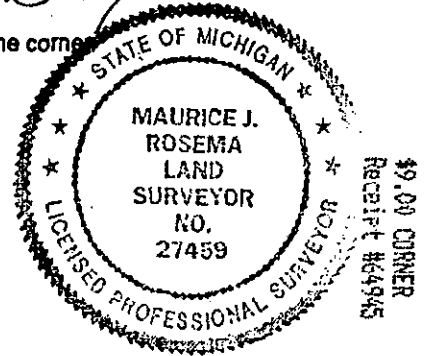

Signed by *Maurice J. Rosema*
Surveyor's Michigan License No. 27459

Date September 11, 1999