

SURVEY & REMONUMENTATION

Ottawa County Remonumentation

APR 24 1995

LAND CORNER RECORDATION CERTIFICATE
Filing Requirement of Act 74, Mich. P.A. 1970

RECORDED

94 DEC 15 AM 11:51

For corners in **COMMISSION**

Polysthia Adelman
REGISTER OF DEEDS
OTTAWA COUNTY, MI

Ottawa (County) Located In: _____ Corner Code # _____

1. Public Land Survey	T <u>7N</u> R <u>13W</u>	<u>I-4</u>
	T _____ R _____	_____
	T _____ R _____	_____
	T _____ R _____	_____
2. Property Controlling in Section	S _____ T _____ R _____	_____
	S _____ T _____ R _____	_____
3. Miscellaneous Property in Sec.	S _____ T _____ R _____	_____
	S _____ T _____ R _____	_____

Register of Deeds Stamp & File Number

4. Lot No. _____, Recorded Plat _____
5. Private Claims _____

	A	B	C	D	E	F	G	H	I	J	K	L	M
2	6		5		4		3		2		1		
3													
4	7		8		9		10		11		12		
5													
6	18		17		16		15		14		13		
7													
8	19		20		21		22		23		24		
9													
10	30		29		28		27		26		25		
11													
12	31		32		33		34		35		36		
13													

Maurice J. Rosema

Jan. 31 94

I, _____, in a field survey on _____, 19_____, do hereby certify that under requirements of P.A. 74, Michigan P.A. of 1970, the corner points mentioned in lines 1 and 2 above were in conformance with regulations and rules therefore as required in the current manual of survey instructions of the United States Department of the Interior, Bureau of Land Management or by a decree of a Court of Law and/or that the corner points mentioned in lines 3, 4 and 5 above were in conformance with the rules of the Michigan Board of Land Surveyors or by a Decree of a Court of Law; established, re-established, monumented, re-monumented, recovered, found as expressed below:

NOTE: Not more than 4 corners, all in the same town and range, may be recorded on this certificate.

A. Description of original monument and accessories and/or subsequent restoration:
I-4

GLO - 1838 signed by R. Whitcomb D.S.	Rosema - 1988 per L.C.R.C. rec. in L. 5, P. 336
8" Beech - S47 W .16 ch.	(over)
6" Lynu. - N18 E .36 ch.	
	Joiner - 1991 per L.C.R.C. rec. in L. 6, P. 194
	(over)

B. Description of corner evidence found and/or method applied in restoring or reestablishing corner:

I-4
Found C.I. mon.
Checks with previous traverse points used to set I-4 as recorded in 1988 per L. 5, P. 336

P.A. 345 OTTAWA COUNTY


PEER APPROVED 4/18/94

Peer Approved Signature

I hereby accept this corner as a correct and accurate perpetuation of the position of the original corner.

C. Description of monument for corner and accessories established to perpetuate locating the position of the corner:

I-4
C.I. mon.
Set nail and remon. tag in SW. side 20" Sycamore - S18° E 289.04'
Set nail and remon. tag in N. side 4" Oak - S34° E 280.05'
Set nail and remon. tag in S. side 6" Box Elder - S70° E 263.80'
Set nail and remon. tag in S. side 12" 12" W. Cherry - S78° E 278.38'
Set nail and remon. tag in S. side 12" Oak - N78° E 309.37'

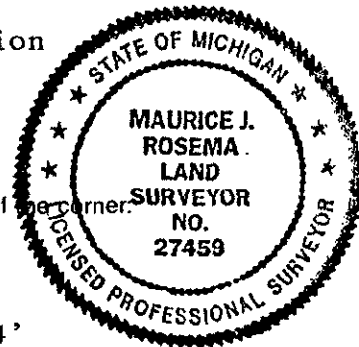

Signed by Maurice J. Rosema Date April 18, 1994
Surveyor's Michigan License No. 27459

Part A - continued

Rosema - 1988 per L.C.R.C. rec. in L. 5, P. 336

Capped 1/2" rerod

P.K. nail in NW. side T. pole - SW. 134.97'

P.K. nail in W. side T. pole - S. 104.45'

P.K. nail in NE. side T. pole - SE. 145.78'

Joiner - 1991 per L.C.R.C. rec. in L. 6, P. 194

C.I. mon.

P.K. nail in NW. side T. pole - SW. 134.97'

P.K. nail in W. side T. pole - S. 104.35'

P.K. nail in NE. side T. pole - SE. 145.78'

DATE #
COST #
EQUIP #
#338

120
9.00
190
2.00