

1993

COMMISSION

Ottawa County remonumentation
LAND CORNER RECORDATION CERTIFICATE
Filing Requirement of Act 74, Mich. P.A. 1970

RECORDED

93 DEC 15 AM 9:27

D. J. ...
REGISTER OF DEEDS
OTTAWA COUNTY, MI

For corners in
Ottawa

(County)

Located In:

Corner Code --#

| | | | | |
|------------------------------------|---|-------|---------|---------|
| 1. Public Land Survey | T | 7N,R | 13W | I-5 |
| | T | _____ | R _____ | _____ |
| | T | _____ | R _____ | _____ |
| | T | _____ | R _____ | _____ |
| 2. Property Controlling in Section | S | _____ | T _____ | R _____ |
| | S | _____ | T _____ | R _____ |
| 3. Miscellaneous Property in Sec. | S | _____ | T _____ | R _____ |
| | S | _____ | T _____ | R _____ |

Register of Deeds Stamp & File Number

4. Lot No. _____, Recorded Plat _____
5. Private Claims _____

I, Maurice J. Rosema, in a field survey on Aug. 2, 19 93, do hereby certify that under requirements of P.A. 74, Michigan P.A. of 1970, the corner points mentioned in lines 1 and 2 above were in conformance with regulations and rules therefore as required in the current manual of survey instructions of the United States Department of the Interior, Bureau of Land Management or by a decree of a Court of Law and/or that the corner points mentioned in lines 3, 4 and 5 above were in conformance with the rules of the Michigan Board of Land Surveyors or by a Decree of a Court of Law; established, re-established, monumented, re-monumented, recovered, found as expressed below:

NOTE: Not more than 4 corners, all in the same town and range, may be recorded on this certificate.

A. Description of original monument and accessories and/or subsequent restoration:

| | |
|---|---|
| I-5 Spicer - 1974 per L.C.R.C. recorded in Liber 2, Page 463 T iron NW. cor. bridge wall - S80°E 68.85' NW. cor. bridge wall - N80°E 67.70' c/l 22" Ash - S40°W 39.30' c/l road - S 4'± 3/4" iron - 1.1' E. and 0.8' N. | Campbell - 1980 per L.C.R.C. recorded in Liber 4, Page 73 Iron NW. bridge cor. - NE. 67.7' SW. bridge cor. - SE. 68.8' |
| | Joiner - 1984 per L.C.R.C. recorded in Liber 5, Page 191 C.I.M. 22" Ash - SSW. 39.40' 14" Ash - NNW. 40.95' SW. cor. bridge post - S80°E 69.93' NW. cor. bridge post - N80°E 67.70' c/l road 4'± S. |


B. Description of corner evidence found and/or method applied in restoring or reestablishing corner:

I-5 Found C.I. monument (top broken - 0.9' below grade)
Found RR. spike in N. side 28" Ash - S42°W 38.49'
NW. cor. conc. bridge post - N85°E 67.63'
SW. cor. conc. bridge post - S75°E 68.88'
Found nail in W. side 22" Ash - N23°W 40.92'
Found nail and tag in SE. side 22" Ash - N46°W 41.45'

I hereby accept this corner as a correct and accurate perpetuation of the position of the original section corner.

C. Description of monument for corner and accessories established to perpetuate locating the position of the corner:

I-5 C.I. monument
Set nail and O.C. remon. tag in NE. side 17" Oak - S57°E 54.85'
Set nail and O.C. remon. tag in W. side 22" Ash - N23°W 40.92'
Set nail and O.C. remon. tag in SE. side 22" Ash - N46°W 41.30'
Set nail and O.C. remon. tag in N. side 28" Ash - S42°W 30.46'
Set nail and O.C. remon. tag in SE. side 17" Ash - N44°E 43.45'
Centerline E-W gravel road - S. 4'±

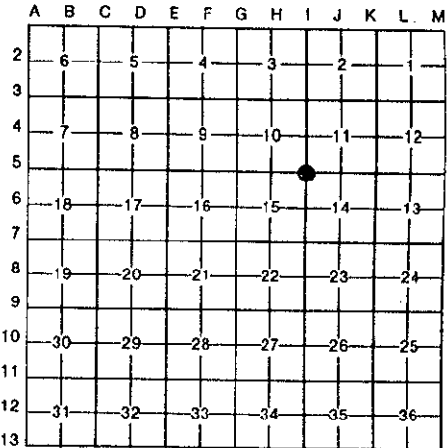

Rosema - 1988 per L.C.R.C. recorded in Liber 5, Page 315
C.I.M.
NW. cor. conc. bridge post - ENE. 67.70'
SW. cor. conc. bridge post - ESE 69.02'
c/l road - S. 4'±
Nail in W. side 22" Ash - NNW. 40.92'
Nail in NW. side 30" Ash - SW. 39.34'



Signed by Maurice J. Rosema Date October 02, 1993

Surveyor's Michigan License No. 27459 Maurice J. Rosema - Tri-Line Surveying