

FEB 24 2000

RECORDED

99 SEP 23 PM 3: 20

OTTAWA COUNTY REMONUMENTATION
LAND CORNER RECORDATION CERTIFICATE
Filing Requirement of Act 74, Mich. P.A. 1970

SECTION

For corners in

OTTAWA

(County)

Located In:

Corner Code #

1. Public Land Survey

T 7N R 13W

I-5 NW Corner

T R

Section 14,

T R

Tallmadge

T R

Township

2. Property Controlling in Section

S T R

S T R

3. Miscellaneous Property in Sec.

S T R

S T R

Randy Sublette
REGISTER OF DEEDS
OTTAWA COUNTY, MI

Seg. 2

Register of Deeds Stamp & File Number

4. Lot No. _____, Recorded Plat _____
5. Private Claims _____

I, Randal J. Vugteveen, in a field survey on August 25, 1999 do hereby state that under requirements of P.A. 74, Michigan P.A. of 1970, the corner points mentioned in lines 1 and 2 above were in conformance with regulations and rules therefore as required in the current manual of survey instructions of the United States Department of the Interior, Bureau of Land Management or by a decree of a Court of Law and /or that the corner points mentioned in lines 3, 4 and 5 above were in conformance with the rules of the Michigan Board of Land Surveyors or by a Decree of a Court of Law; established, re-established, monumented, recovered, found as expressed below.

NOTE: Not more than 2 corners, all in the same town and range, may be recorded on this certificate.

	A	B	C	D	E	F	G	H	I	J	K	L
1												
2	6		5		4		3		2		1	
3												
4	7		8		9		10		11		12	
5												
6	18		17		16		15		14		13	
7												
8	19		20		21		22		23		24	
9												
10	30		29		28		27		26		25	
11												
12	31		32		33		34		35		36	
13												

A. Description of original monument and accessories and/or subsequent restoration:

I-5 Ottawa County Remonumentation Certificate

Liber 1, Page 206 Rosema 1993

I-5 C.I. monument

Nail and Remon Tag NE side 17" Oak S57°E 54.85'

Nail and Remon Tag W side 22" Ash N23° W 40.92'

Nail and Remon Tag SE side 22" Ash N46°W 41.30'

Nail and Remon Tag N side 28" Ash S42°W 30.46'

Nail and Remon Tag SE side 17" Ash N44°E 43.45'

Centerline E-W gravel road South 4' +/-

B. Description of corner evidence found and/or method applied in restoring or reestablishing corner:

I-5 Found busted C.I. Monument June 3, 1999

Found Nail & Remon Tag NE side 17" Oak S57°E 54.84'

Found Nail & Remon Tag W side 18" Ash N23°W 40.92'

Found Nail & Remon Tag SE side (face) 18" Ash N46°W 41.28'

Found Nail & Remon Tag SE side 17" Ash N44°E 43.43'

(Ottawa County Road Commission is rebuilding the road at this time).

Accepted busted Cast Iron Monument as a careful and faithful perpetuation of the position of the original corner.

Set Witness Iron Control outside of construction.

August 25, 1999 recovered witness irons and set 3/4" X 24" Iron Bar with Remonumentation Cap

*9/13/99
YD*

C. Description of monument for corner and accessories established to perpetuate locating the position of the corner:

I-5 3/4" X 24" iron bar with Ottawa County Remonumentation Cap


Found Nail and Ottawa County Remon Tag in NE side 17" Oak S57°E 54.84'

Found Nail and Ottawa County Remon Tag in W side 18" Ash N23°W 40.92'

Found Nail and Ottawa County Remon Tag in SE side (face) 18" Ash N46°W 41.28'

Found Nail and Ottawa County Remon Tag in SE side 17" Ash N44°E 43.43'

Centerline (new) E & W Gravel Road South 4.0' (To be paved soon)

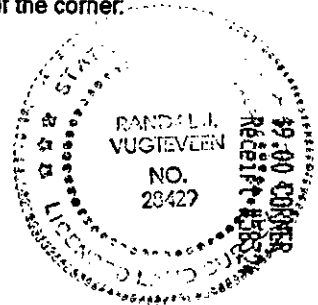

41.00 PHOTO
Receipt #58324

Signed by *Randal J. Vugteveen*

Date 9/12/99

Surveyor's Michigan License No. 28429