

**SURVEY & REMONUMENTATION**

APR 24 1995

**COMMISSION**

Ottawa County Remonumentation

**LAND CORNER RECORDATION CERTIFICATE**

Filing Requirement of Act 74, Mich. P.A. 1970

RECORDED

94 DEC 15 AM 11:51

*Elizabeth Ackerman*  
REGISTER OF DEEDS  
OTTAWA COUNTY, MI

For corners in

Ottawa  
(County)

Located In:

Corner Code #

- |                                    |                          |            |
|------------------------------------|--------------------------|------------|
| 1. Public Land Survey              | T <u>7N</u> R <u>13W</u> | <u>I-6</u> |
|                                    | T _____ R _____          | _____      |
|                                    | T _____ R _____          | _____      |
|                                    | T _____ R _____          | _____      |
| 2. Property Controlling in Section | S _____ T _____ R _____  | _____      |
|                                    | S _____ T _____ R _____  | _____      |
| 3. Miscellaneous Property in Sec.  | S _____ T _____ R _____  | _____      |
|                                    | S _____ T _____ R _____  | _____      |

Register of Deeds Stamp & File Number

4. Lot No. \_\_\_\_\_, Recorded Plat \_\_\_\_\_  
5. Private Claims \_\_\_\_\_

	A	B	C	D	E	F	G	H	I	J	K	L	M
2	6	5	4	3	2	1							
3													
4	7	8	9	10	11	12							
5													
6	18	17	16	15	14	13							
7													
8	19	20	21	22	23	24							
9													
10	30	29	28	27	26	25							
11													
12	31	32	33	34	35	36							
13													

Maurice J.

I, Rosema, in a field survey on Jan. 4, 1994, do hereby certify that under requirements of P.A. 74, Michigan P.A. of 1970, the corner points mentioned in lines 1 and 2 above were in conformance with regulations and rules therefore as required in the current manual of survey instructions of the United States Department of the Interior, Bureau of Land Management or by a decree of a Court of Law and/or that the corner points mentioned in lines 3, 4 and 5 above were in conformance with the rules of the Michigan Board of Land Surveyors or by a Decree of a Court of Law; established, re-established, monumented, re-monumented, recovered, found as expressed below:

**NOTE: Not more than 4 corners, all in the same town and range, may be recorded on this certificate.**

A. Description of original monument and accessories and/or subsequent restoration:  
I-6

- |                           |                             |
|---------------------------|-----------------------------|
| GLO - 1838 by             | Englert - 1972 per L.C.R.C. |
| R. Whitcomb D.S.          | rec. in L. 1, P. 707 (over) |
| 40" Pine - N17 E .22 ch.  | Rosema - 1988 per L.C.R.C.  |
| 36" Walnut - N74 W .9 ch. | rec. in L. 5, P. 334 (over) |
|                           | Joiner - 1991 per L.C.R.C.  |
|                           | rec. in L. 6, P. 194 (over) |

B. Description of corner evidence found and/or method applied in restoring or reestablishing corner:  
I-6

- Found C.I. mon.  
Found spike in S. side 6" Ash - S65°W 21.18'  
Found nail in E. side 15" Maple - N15°E 45.35'  
Found nail in W. side 14" Maple - N55°E 43.62'


PA. 345 OTTAWA COUNTY  
PEER APPROVED 4/18/94

*Murray D. Nedeweld*

I hereby accept this corner as a correct and accurate perpetuation of the position of the original corner.

C. Description of monument for corner and accessories established to perpetuate locating the position of the corner:  
I-6

- Set nail and remon. tag in S. side 6" Ash - S65°W 21.18'  
Set nail and remon. tag in NE. side 12" Box Elder - S67°E 8.32'  
Set nail and remon. tag in E. side 15" Maple - N15°E 45.35'  
Set nail and remon. tag in N. side 14" Maple - N55°E 43.62'  
On E.-W. wire fence line

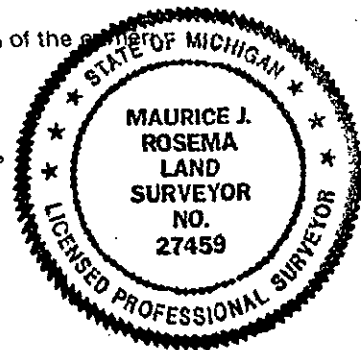

Signed by *Maurice J. Rosema*  
Surveyor's Michigan License No. 27459

Date April 18, 1994

Part A - continued

Englert - 1972 per L.C.R.C. rec. in L. 1, P. 707

3/4" Pipe

8" Tree - E. 12.60'

8" Tree - SE. 8.42'

Centerline of steel fence post in conc. - ENE. 0.7'

Rosema - 1988 per L.C.R.C. rec. in L. 5, P. 334

3/4" Pipe

Nail in N. side 12" Maple - NE. 43.70'

Nail in E. side 12" Maple - NNE. 45.26'

On E.-W. fence line

Centerline of N.-S. creek - E. 23'

Joiner - 1991 per L.C.R.C. rec. in L. 6, P. 194


C.I. mon.

10" Box Elder - SE. 8.32'

12" Maple - N. 45.33'

11" Maple - NE. 43.68'

4" Ash - W. 21.18'

 

COPIE #  
OPERATOR  
DATE #  
HOURS