

RECORDED

Ottawa County Remonumentation
LAND CORNER RECORDATION CERTIFICATE
Filing Requirement of Act 74, Mich. P.A. 1970

DEC 18 PM 4:54

For corners in

Ottawa (County)

Located In:

Corner Code #

- 1. Public Land Survey T 7N R 13W I-9
T _____ R _____ (SW cor., Sec. 23)
T _____ R _____
T _____ R _____
- 2. Property Controlling S _____ T _____ R _____
in Section S _____ T _____ R _____
- 3. Miscellaneous S _____ T _____ R _____
Property in Sec. S _____ T _____ R _____

D. J. ...
REGISTER OF DEEDS
OTTAWA COUNTY, MI

Register of Deeds Stamp & File Number

- 4. Lot No. _____, Recorded Plat _____
- 5. Private Claims _____

	A	B	C	D	E	F	G	H	I	J	K	L	M
2	6	5	4	3	2	1							
3													
4	7	8	9	10	11	12							
5													
6	18	17	16	15	14	13							
7													
8	19	20	21	22	23	24							
9													
10	30	29	28	27	26	25							
11													
12	31	32	33	34	35	36							
13													

I, Maurice J. Rosema, in a field survey on Dec. 6, 1996, do hereby certify that under requirements of P.A. 74, Michigan P.A. of 1970, the corner points mentioned in lines 1 and 2 above were in conformance with regulations and rules therefore as required in the current manual of survey instructions of the United States Department of the Interior, Bureau of Land Management or by a decree of a Court of Law and/or that the corner points mentioned in lines 3, 4 and 5 above were in conformance with the rules of the Michigan Board of Land Surveyors or by a Decree of a Court of Law; established, re-established, monumented, re-monumented, recovered, found as expressed below:

NOTE: Not more than 4 corners, all in the same town and range, may be recorded on this certificate.

A. Description of original monument and accessories and/or subsequent restoration:

I-9
GLO - 1837 by Whitcomb
Post

LCRC recorded in Liber 5, Page 282 (1987)
1" rod in monument box
PK nail in in E side P pole - S 52.73'
PK nail in top of wood post (4th post from end) -
- SE 68.64'
Centerline of Mich. Con. manhole - SW 58.48'
Nail in W side 15" Hickory - N 36.05'
Centerline of E-W bit. conc. road - S 1.9'

B. Description of corner evidence found and/or method applied in restoring or reestablishing corner:

I-9
Found 3/4" x 18" steel rod in monument box, replaced with 5/8" x 3' steel rod with remon. cap
Found PK nail in S side P pole - S 52.75'
Found nail in W side 15" Hickory - N 36.06'
Centerline of Mich. Con. manhole - SW 58.50'
Centerline of E-W bit. conc. road - S 1.6'


I hereby accept this corner as a correct and accurate perpetuation of the position of the original corner.

P.A. 345 OTTAWA COUNTY
PEER APPROVED 12-9-96

M.J.R.

C. Description of monument for corner and accessories established to perpetuate locating the position of the corner:

I-9
5/8" x 3' steel rod with remon. cap
Set nail and remon. tag in E side P pole - S5°E 52.75'
Set nail and remon. tag in W side 15" Hickory - N0°E 36.06'
Set nail and remon. tag in NE side 12" Pine - N39°W 72.42'
Centerline of Mich. Con. manhole - S30°W 58.50'
Centerline of E-W bit. conc. road - S 1.6'

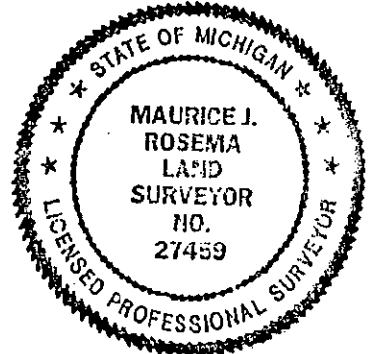

Signed by Maurice J. Rosema
Surveyor's Michigan License No. 27459

Date Dec. 8, 1996