

RECORDED

99 OCT 27 PM 1:49

FEB 24 2000

Ottawa County Remonumentation  
LAND CORNER RECORDATION CERTIFICATE  
Filing Requirement of Act 74, Mich. P.A. 1970

*Gay Sublette*  
REGISTER OF DEEDS  
OTTAWA COUNTY MI

For corners in SECTION

Ottawa

(County)

Located in:

Corner Code #

- 1. Public Land Survey T 7N R 13W I-12  
T \_\_\_ R \_\_\_ W $\frac{1}{4}$  corner of Section 35  
T \_\_\_ R \_\_\_ Tallmadge Township  
T \_\_\_ R \_\_\_
- 2. Property Controlling S \_\_\_ T \_\_\_ R \_\_\_  
in Section S \_\_\_ T \_\_\_ R \_\_\_
- 3. Miscellaneous S \_\_\_ T \_\_\_ R \_\_\_  
Property in Sec. S \_\_\_ T \_\_\_ R \_\_\_

Register of Deeds Stamp & File Number

- 4. Lot No. \_\_\_\_\_, Recorded Plat \_\_\_\_\_
- 5. Private Claims \_\_\_\_\_

I, Maurice J. Rosema, in a field survey on Sept. 10, 1999 do hereby state that under requirements of P.A. 74, Michigan P.A. of 1970, the corner points mentioned in lines 1 and 2 above were in conformance with regulations and rules therefore as required in the current manual of survey instructions of the United States Department of the Interior, Bureau of Land Management or by a decree of a Court of Law and /or that the corner points mentioned in lines 3, 4 and 5 above were in conformance with the rules of the Michigan Board of Land Surveyors or by a Decree of a Court of Law; established, re-established, monumented, recovered, found as expressed below:

NOTE: Not more than 2 corners, all in the same town and range, may be recorded on this certificate.

A	B	C	D	E	F	G	H	I	J	K	L	M
1												
2	6		5		4		3		2		1	
3												
4	7		8		9		10		11		12	
5												
6	18		17		16		15		14		13	
7												
8	19		20		21		22		23		24	
9												
10	30		29		28		27		26		25	
11												
12	31		32		33		34	●	35		36	
13												

A. Description of original monument and accessories and/or subsequent restoration:

- I-12  
GLO - 1838 LCRC per Liber 1, Page 767  
Whitcomb D.S. (VanKooten - 1972)  
10" W. Oak - Iron  
S21°E 17 links 30" dbl. Oaks - S. 46.2'  
28" W. Oak - 12" Maple - SSW. 93.6'  
S71°W 25 links SE. cor. brick garage - NW. 126.83'  
SW. cor. barn - NNE. 66.0'  
c/l pavement - S. 7.0' Nail in P. pole - ENE. 44.28'
- LCRC per Liber 6, Page 176  
(Joiner - 1991)  
Cast iron monument  
14" quad. Chestnut - NW. 61.76'  
16" Chestnut - SE. 96.95'  
22" tw. Oak - SSE. 46.43'  
Power pole - SW. 138.98'  
NW. cor. hse. fndn. - SW. 132.88'


B. Description of corner evidence found and/or method applied in restoring or reestablishing corner:

- I-12  
Found Cast iron monument in mon. box in bit. conc. road 0.7' below grade  
SE. corner of brick garage - N42°W 126.99'  
NW. corner of house foundation - S42°W 132.82'  
Centerline of E.-W. bit. conc. road - S. 7'

I hereby accept this corner as a correct and accurate perpetuation of the position of the original corner.

C. Description of monument for corner and accessories established to perpetuate locating the position of the corner:

- I-12  
Cast iron monument in monument box  
Set nail and remonumentation tag in W. side twin 20" Oak - S0°E 46.77'  
Set nail and remonumentation tag in NE. side 20" Walnut - S47°E 97.10'  
SE. corner of brick garage - N42°W 126.99'  
NW. corner of house foundation - S42°W 132.82'  
Centerline of E.-W. bit. conc. road - S. 7'

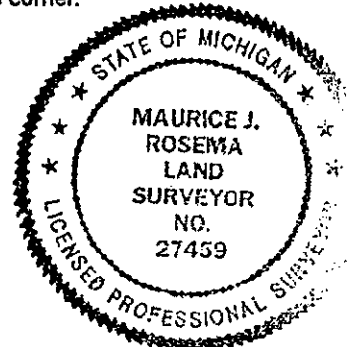

Receipt #61757

*9/13/99*  
*YDZ*

Signed by *Maurice J. Rosema*  
Surveyor's Michigan License No. 27459

Date September 11, 1999