

1993

LAND CORNER RECORDATION CERTIFICATE

Filing Requirement of Act 74, Mich. P.A. 1970

For corners in

COMMISSION

REGISTER OF DEEDS
OTTAWA COUNTY, MI

Ottawa (County)	Located In:	Corner Code --#
1. Public Land Survey	T <u>7</u> R <u>13</u>	J-3
	T _____ R _____	_____
	T _____ R _____	_____
	T _____ R _____	_____
2. Property Controlling in Section	S _____ T _____ R _____	_____
	S _____ T _____ R _____	_____
3. Miscellaneous Property in Sec.	S _____ T _____ R _____	_____
	S _____ T _____ R _____	_____

Register of Deeds Stamp & File Number

- 4. Lot No. _____, Recorded Plat _____
- 5. Private Claims _____

	A	B	C	D	E	F	G	H	I	J	K	L	M
2	6		5		4		3		2		1		
3													
4	7		8		9		10		11		12		
5													
6	18		17		16		15		14		13		
7													
8	19		20		21		22		23		24		
9													
10	30		29		28		27		26		25		
11													
12	31		32		33		34		35		36		
13													

I, Maurice J. Rosema, in a field survey on August 2, 19 93, do hereby certify that under requirements of P.A. 74, Michigan P.A. of 1970, the corner points mentioned in lines 1 and 2 above were in conformance with regulations and rules therefore as required in the current manual of survey instructions of the United States Department of the Interior, Bureau of Land Management or by a decree of a Court of Law and/or that the corner points mentioned in lines 3, 4 and 5 above were in conformance with the rules of the Michigan Board of Land Surveyors or by a Decree of a Court of Law; established, re-established, monumented, re-monumented, recovered, found as expressed below:

NOTE: Not more than 4 corners, all in the same town and range, may be recorded on this certificate.

A. Description of original monument and accessories and/or subsequent restoration:


J-3
 3/4" iron per LCRC recorded in Liber 3, Page 202 - Nov. 1977
 nail in side P. Pole - N. 51.93'
 nail in side 12" twin W. Cherry - SSE. 82.67'
 nail in face of leaning RR tie fence post - SW. 43.65'
 nail in side 6" Ash - WNW. 26.65'

C.I. mon. per LCRC recorded in Liber 6, Page 86 - Nov. 1990
 15" twin Cherry - SSE. 82.70'
 10" twin Elm - SW. 109.79'
 P. Pole - NNW. 51.56'
 9" Ash - SE. 96.62'

B. Description of corner evidence found and/or method applied in restoring or reestablishing corner:

J-3
 found C.I. mon. (0.6' below grade)
 found nail in W. side 15" twin W. Cherry - S15°E 82.64'
 found nail in N. side 11" tree stump - S70°E 96.53'
 found nail in S. side P. Pole - N0°E 51.56'

I hereby accept this corner as a correct and accurate perpetuation of the position of the original section corner.

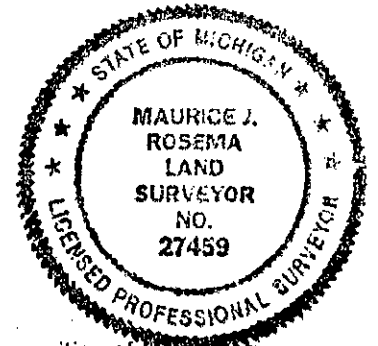

C. Description of monument for corner and accessories established to perpetuate locating the position of the corner:

J-3
 C.I. mon. (0.6' below grade)
 set nail and O.C. tag in NW. side wood fence post - S39°E 57.79'
 set nail and O.C. tag in W. side 15" twin W. Cherry - S15°E 82.64'
 set nail and O.C. tag in N. side 11" tree stump - S70°E 96.53'
 set nail and O.C. tag in SW. side 7" Locust - N40°W 28.70'
 set nail and O.C. tag in S. side P. Pole - N0°E 51.52'
 on centerline of gravel road S. and on centerline E.-W. gravel road

Signed by Maurice J. Rosema Date September 20, 1993

Surveyor's Michigan License No. 27459 - Tru-Line Surveying