

RECORDED

93 DEC 15 AM 9:28

1889 Ottawa County remonumentation

LAND CORNER RECORDATION CERTIFICATE

COMMISSION

Filing Requirement of Act 74, Mich. P.A. 1970

For corners in  
Ottawa  
(County)

Located In:

Corner Code #

1. Public Land Survey	T	7N	R	13W	J-7
	T		R		
	T		R		
	T		R		
2. Property Controlling in Section	S		T	R	
	S		T	R	
3. Miscellaneous	S		T	R	
Property in Sec.	S		T	R	

*Margaret Williams*  
REGISTER OF DEEDS  
OTTAWA COUNTY, MI

Register of Deeds Stamp & File Number

4. Lot No. \_\_\_\_\_, Recorded Plat \_\_\_\_\_  
5. Private Claims \_\_\_\_\_

I, Maurice J. Rosema, in a field survey on Aug. 2, 19 93, do hereby certify that under requirements of P.A. 74, Michigan P.A. of 1970, the corner points mentioned in lines 1 and 2 above were in conformance with regulations and rules therefore as required in the current manual of survey instructions of the United States Department of the Interior, Bureau of Land Management or by a decree of a Court of Law and/or that the corner points mentioned in lines 3, 4 and 5 above were in conformance with the rules of the Michigan Board of Land Surveyors or by a Decree of a Court of Law; established, re-established, monumented, re-monumented, recovered, found as expressed below:

A	B	C	D	E	F	G	H	I	J	K	L	M
2	6	5	4	3	2	1						
3												
4	7	8	9	10	11	12						
5												
6	18	17	16	15	14	13						
7												
8	19	20	21	22	23	24						
9												
10	30	29	28	27	26	25						
11												
12	31	32	33	34	35	36						
13												

NOTE: Not more than 4 corners, all in the same town and range, may be recorded on this certificate.

A. Description of original monument and accessories and/or subsequent restoration:

<b>J-7</b> VanKooten - 1973 per L.C.R.C. recorded in Liber 2, Page 325 P.K. nail Spike in E. side 36" Oak - SSW. 30.12' Spike in E. side 18" Oak - NNE. 36.19' SE. cor. conc. block bldg. - NNW. 40.86' SE. cor. conc. block bldg. - NW. 60.24'	<b>Joiner</b> - 1984 per L.C.R.C. recorded in Liber 5, Page 176 C.I. monument 40" Oak - SW. 30.95' SW. cor. conc. block gar. - WNW. 60.30' 16" Oak - NNE. 36.20'  15" Oak - ENE. 95.26'	<b>Joiner</b> - 1990 per L.C.R.C. recorded in Liber 6, Page 84 C.I. monument 36" Oak - SSW. 29.92' Tri. 12" Ash - SSE. 43.53' Gar. cor. - NNW. 40.91' 22" Oak - NNE. 36.21'
---	---	---


B. Description of corner evidence found and/or method applied in restoring or reestablishing corner:

**J-7** Found C.I. monument in monument box  
Found nail in E. side 44" Oak - S12°W 29.92'  
SW. cor. conc. block gar. - N50°W 60.30'  
SE. cor. conc. block gar. - N20°W 40.91'  
Found nail in NE. side 14" Tri. Ash - S15°E 43.50'

I hereby accept this corner as a correct and accurate perpetuation of the original section corner.

C. Description of monument for corner and accessories established to perpetuate locating the position of the corner:

**J-7** C.I. monument in monument box  
Set nail and O.C. remon. tag in W. side 24" Oak - N9°E 36.21'  
Set nail and O.C. remon. tag in E. side 44" Oak - S12°W 29.92'  
Set nail and O.C. remon. tag in NE. side Tri. 14" Ash - S15°E 43.50'  
Set nail and O.C. remon. tag in NW. side 19" Oak - N77°E 95.26'  
Set nail and O.C. remon. tag in N. side 13" Tw. Pine - S73°W 108.52'

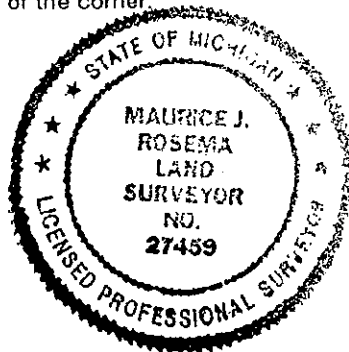

Signed by *Maurice J. Rosema* Date Oct. 02, 1993  
Maurice J. Rosema - Tru-Line Surveying  
Surveyor's Michigan License No. 27459