

FEB 24 2000

RECORDED

99 OCT 27 PM 1:49

SECTION

Ottawa County Remonumentation  
LAND CORNER RECORDATION CERTIFICATE  
Filing Requirement of Act 74, Mich. P.A. 1970

*Gary Schell*  
REGISTER OF DEEDS  
OTTAWA COUNTY, MI

For corners in

Ottawa  
(County)

Located In:

Corner Code #

- 1. Public Land Survey      T 7N R 13W      J-9  
    T    R                    N 1/4 corner, Section 26  
    T    R                    Talmadge Township  
    T    R                    \_\_\_\_\_
- 2. Property Controlling    S    T    R                    \_\_\_\_\_  
    in Section                S    T    R                    \_\_\_\_\_
- 3. Miscellaneous            S    T    R                    \_\_\_\_\_  
    Property in Sec.         S    T    R                    \_\_\_\_\_

Register of Deeds Stamp & File Number

- 4. Lot No. \_\_\_\_\_, Recorded Plat \_\_\_\_\_
- 5. Private Claims \_\_\_\_\_

I, Maurice J. Rosema, in a field survey on Sept. 9, 1999 do hereby state that under requirements of P.A. 74, Michigan P.A. of 1970, the corner points mentioned in lines 1 and 2 above were in conformance with regulations and rules therefore as required in the current manual of survey instructions of the United States Department of the Interior, Bureau of Land Management or by a decree of a Court of Law and/or that the corner points mentioned in lines 3, 4 and 5 above were in conformance with the rules of the Michigan Board of Land Surveyors or by a Decree of a Court of Law; established, re-established, monumented, recovered, found as expressed below:

NOTE: Not more than 2 corners, all in the same town and range, may be recorded on this certificate.

A	B	C	D	E	F	G	H	I	J	K	L	M
1												
2	6	5	4	3	2	1						
3												
4	7	8	9	10	11	12						
5												
6	18	17	16	15	14	13						
7												
8	19	20	21	22	23	24						
9									●			
10	30	29	28	27	26	25						
11												
12	31	32	33	34	35	36						
13												

A. Description of original monument and accessories and/or subsequent restoration:

J-9  
 GLO - 1838                    LCRC per Liber 1, Page 573  
 R. Whitcomb D.S.         (Roon - 1972)  
 Set post                     1 1/2" Pipe  
 20" W. Oak - S34°W        Telephone pole - WNW. 67.20'  
    23 links                    Telephone pole - ENE. 98.23'  
 10" W. Oak - S7°E         Edge of M-45 - S. 8.6  
    48 links

LCRC per Liber 6, Page 187  
 (Joiner - 1991)  
 re-rod in mon. box  
 38" Oak - N. 61.38'  
 Power pole - SE. 90.03'  
 Tele. pole - NE. 111.43'  
 20" Maple - NW. 100.73'

B. Description of corner evidence found and/or method applied in restoring or reestablishing corner:


J-9  
 Found 1/2" re-rod in monument box, replaced iron rod with 3/4" x 3' steel rod with remonumentation cap  
 Found nail in W. side 30" Oak - N. 61.31'

I hereby accept this corner as a correct and accurate perpetuation of the position of the original corner.

C. Description of monument for corner and accessories established to perpetuate locating the position of the corner:

J-9  
 3/4" x 3' steel rod with remonumentation cap in monument box  
 Set nail and remonumentation tag in E. side Power pole - N35°W 89.88'  
 Set nail and remonumentation tag in W. side 30" Oak - N5°W 61.31'  
 Set nail and remonumentation tag in S. side 20" Maple - N65°W 100.69'  
 Set nail and remonumentation tag in E. side 24" Maple - N17°W 82.44'  
 Centerline of E.-W. bit. conc. road - S. 2'  
 On tree row N.-S.

9/13/99  
*YDZ*

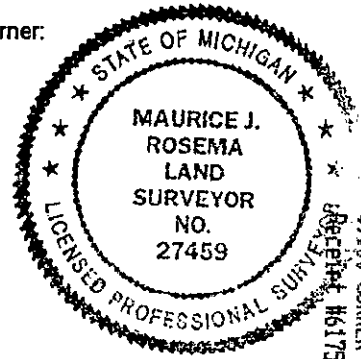

Signed by *Maurice J. Rosema*  
Surveyor's Michigan License No. 27459

Date September 11, 1999