

1883
COMMISSION

Ottawa County remonumentation
LAND CORNER RECORDATION CERTIFICATE
Filing Requirement of Act 74, Mich. P.A. 1970

RECORDED

93 DEC 15 AM 9:27

Polycarpus Robinson
REGISTER OF DEEDS
OTTAWA COUNTY, MI

For corners in

Ottawa (County)	Located In:	Corner Code #
1. Public Land Survey	T <u>7N</u> R <u>13W</u>	<u>K-4</u>
	T _____ R _____	_____
	T _____ R _____	_____
	T _____ R _____	_____
2. Property Controlling in Section	S _____ T _____ R _____	_____
	S _____ T _____ R _____	_____
3. Miscellaneous Property in Sec.	S _____ T _____ R _____	_____
	S _____ T _____ R _____	_____
4. Lot No. _____, Recorded Plat _____		
5. Private Claims _____		

Register of Deeds Stamp & File Number

I, Maurice J. Rosema in a field survey on August 2, 19 93, do hereby certify that under requirements of P.A. 74, Michigan P.A. of 1970, the corner points mentioned in lines 1 and 2 above were in conformance with regulations and rules therefore as required in the current manual of survey instructions of the United States Department of the Interior, Bureau of Land Management or by a decree of a Court of Law and/or that the corner points mentioned in lines 3, 4 and 5 above were in conformance with the rules of the Michigan Board of Land Surveyors or by a Decree of a Court of Law; established, re-established, monumented, re-monumented, recovered, found as expressed below:

	A	B	C	D	E	F	G	H	I	J	K	L	M
2	6	5	4	3	2	1							
3													
4	7	8	9	10	11	12							
5													
6	18	17	16	15	14	13							
7													
8	19	20	21	22	23	24							
9													
10	30	29	28	27	26	25							
11													
12	31	32	33	34	35	36							
13													

NOTE: Not more than 4 corners, all in the same town and range, may be recorded on this certificate.

A. Description of original monument and accessories and/or subsequent restoration:

K-4 Exxel - 1972 per L.C.R.C. recorded in Liber 1, Page 719	Spicer - 1974 per L.C.R.C. recorded in Liber 2, Page 461
1/2" rod in 3/4" iron	1/2" solid iron
Nail in side T. pole - E. 25.19'	T. pole - N85°E 25.25'
NW. corner bricks on house - ESE. 113.99'	P. pole - S15°W 101.60'
Nail in side P. pole - SSE. 110.27'	T. pole - S90°W 34.13'
Nail in side P. pole - SSW. 101.56'	P. pole - S25°E 110.35'
Nail in side T. pole - W. 34.2'	

B. Description of corner evidence found and/or method applied in restoring or reestablishing corner:

K-4 Found C.I. monument in monument box
 NW. corner of brick on house - S80°E 113.91'
 Found P.K. nail in W. side P. pole - S17°W 104.02'
 Found P.K. nail in S. side T. pole - S90°W 34.20'
 Found P.K. nail in W. side P. pole - S23°E 110.30'

Nederveld - 1976 per L.C.R.C. recorded in Liber 3, Page 144
 capped iron on centerline
 P.K. in W. side P. pole - W. 34.21'
 P.K. in S. side T. pole - E. 25.21'
 P.K. in W. side P. pole - SSE. 110.30'
 P.K. in W. side P. pole - SSW 104.04'


I hereby accept this corner as a correct and accurate perpetuation of the position of the original section corner.

C. Description of monument for corner and accessories established to perpetuate locating the position of the corner:

K-4 C.I. monument in monument box
 Set nail and O.C. remon. tag in S. side T. pole - S90°W 34.20'
 Set nail and O.C. remon. tag in W. side P. pole - S17°W 104.02'
 Set nail and O.C. remon. tag in W. side P. pole - S23°E 110.30'
 Set nail and O.C. remon. tag in top of split-rail fence post - N50°E 43.33'

Signed by *Maurice J. Rosema*
Maurice J. Rosema - Tri-Line Surveying
Surveyor's Michigan License No. 27459

Date October 02, 1993

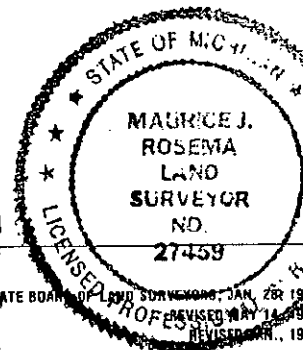

FORM APPROVED BY MICHIGAN STATE BOARD OF LAND SURVEYORS, JAN. 28, 1989, REVISED MAY 14, 1989, REVISED JAN., 1991