

SURVEY & REMONUMENTATION

APR 24 1995

COMMISSION

Ottawa Copnty remonumentation
LAND CORNER RECORDATION CERTIFICATE
 Filing Requirement of Act 74, Mich. P.A. 1970

RECORDED
 94 DEC 15 AM 11:49

Richard Robinson
 REGISTER OF DEEDS
 OTTAWA COUNTY, MI

For corners in
 Ottawa

(County)

Located In:

Corner Code #

1. Public Land Survey	T <u>7N</u> R <u>13W</u>	<u>K-5</u>
	T _____ R _____	_____
	T _____ R _____	_____
	T _____ R _____	_____
2. Property Controlling in Section	S _____ T _____ R _____	_____
	S _____ T _____ R _____	_____
3. Miscellaneous Property in Sec.	S _____ T _____ R _____	_____
	S _____ T _____ R _____	_____

Register of Deeds Stamp & File Number

4. Lot No. _____, Recorded Plat _____
 5. Private Claims _____

	A	B	C	D	E	F	G	H	I	J	K	L	M
2	6	5	4	3	2	1							
3													
4	7	8	9	10	11	12							
5													
6	18	17	16	15	14	13							
7													
8	19	20	21	22	23	24							
9													
10	30	29	28	27	26	25							
11													
12	31	32	33	34	35	36							
13													

I, Maurice J. Rosema in a field survey on Jan. 3, 19 94
 do hereby certify that under requirements of P.A. 74, Michigan P.A. of 1970, the corner points mentioned in lines 1 and 2 above were in conformance with regulations and rules therefore as required in the current manual of survey instructions of the United States Department of the Interior, Bureau of Land Management or by a decree of a Court of Law and/or that the corner points mentioned in lines 3, 4 and 5 above were in conformance with the rules of the Michigan Board of Land Surveyors or by a Decree of a Court of Law; established, re-established, monumented, re-monumented, recovered, found as expressed below:

NOTE: Not more than 4 corners, all in the same town and range, may be recorded on this certificate.

A. Description of original monument and accessories and/or subsequent restoration:

K-5 Exxel - 1972 per L.C.R.C.
 recorded in L. 1, P. 609
 1/2" Iron
 Nail in side P. pole - SE. 67.32'
 Nail in side T. pole - SSW. 64.58'
 SW. cor. house - NE. 106.92'

Joiner - 1984 per L.C.R.C.
 recorded in L. 5, P. 191
 C.I.M.
 P. pole - SE. 67.10'
 SW. cor. hse. - NE. 106.90'
 14" Tree - WSW. 111.62'
 Street sign - NW. 45.05'

B. Description of corner evidence found and/or method applied in restoring or reestablishing corner:

K-5
 Found C.I. mon. in mon. box
 Found P.K. nail in SE. side wood post - S62°W 45.26'
 Found P.K. nail in NE. side wood post - N42°W 49.17'
 SW. cor. house - N45°E 106.90'


G.L.O. - 1838 signed by
 R. Whitcomb D.S.
 10" Maple - N47°W .6 ch.
 6" Sugar - S22°E .28 ch.

I hereby accept this corner as correct and accurate perpetuation of the position of the original corner.

345 OTTAWA COUNTY
 APPROVED 4/18/94
Robert D. Nedevold

C. Description of monument for corner and accessories established to perpetuate locating the position of the corner:

K-5
 C.I. mon. in mon. box
 Set nail and remon. tag in N. side P. pole - S49°E 68.49'
 Set nail and remon. tag in SE. side wood post - S62°W 45.26'
 Set nail and remon. tag in NE. side wood post - N42°W 49.17'
 SW. cor. of house - N45°E 106.90'

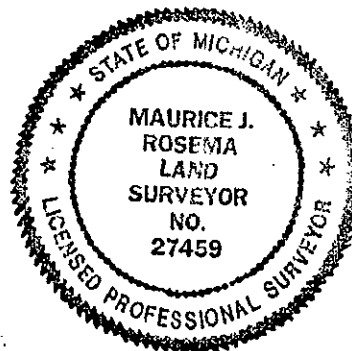

Signed by *Maurice J. Rosema* Date April 18, 1994
 Surveyor's Michigan License No. 27459