

SURVEY & REMONUMENTATION

APR 24 1995

COMMISSION

For corners in
Ottawa

(County)

Located In:

Corner Code #

- | | | |
|---------------------------------------|--------------------------|------------|
| 1. Public Land Survey | T <u>7N</u> R <u>13W</u> | <u>K-7</u> |
| | T _____ R _____ | _____ |
| | T _____ R _____ | _____ |
| | T _____ R _____ | _____ |
| 2. Property Controlling in Section | S _____ T _____ R _____ | _____ |
| | S _____ T _____ R _____ | _____ |
| 3. Miscellaneous Property in Sec. | S _____ T _____ R _____ | _____ |
| | S _____ T _____ R _____ | _____ |
| 4. Lot No. _____, Recorded Plat _____ | | |
| 5. Private Claims _____ | | |

RECORDED

94 DEC 15 AM 11:49

Register of Deeds
REGISTER OF DEEDS
OTTAWA COUNTY, MI

Register of Deeds Stamp & File Number

	A	B	C	D	E	F	G	H	I	J	K	L	M
2	6	5	4	3	2	1							
3													
4	7	8	9	10	11	12							
5													
6	18	17	16	15	14	13							
7													
8	19	20	21	22	23	24							
9													
10	30	29	28	27	26	25							
11													
12	31	32	33	34	35	36							
13													

I, Maurice J. Rosema, in a field survey on Jan. 2, 1994, do hereby certify that under requirements of P.A. 74, Michigan P.A. of 1970, the corner points mentioned in lines 1 and 2 above were in conformance with regulations and rules therefore as required in the current manual of survey instructions of the United States Department of the Interior, Bureau of Land Management or by a decree of a Court of Law and/or that the corner points mentioned in lines 3, 4 and 5 above were in conformance with the rules of the Michigan Board of Land Surveyors or by a Decree of a Court of Law; established, re-established, monumented, re-monumented, recovered, found as expressed below:

NOTE: Not more than 4 corners, all in the same town and range, may be recorded on this certificate.

A. Description of original monument and accessories and/or subsequent restoration:


- | | | |
|--|---|---|
| K-7 Spicer - 1974 per
L.C.R.C. recorded in
L. 2, P. 701
3/4" iron
MBT pole - N25°W 62.65'
Guy pole - S15°W 103.80'
C.P. pole - S45°E 81.10' | Clapp - 1976 per
L.C.R.C. recorded in
L. 3, P. 98
T. pole - NNW. 62.59'
P. pole - SE. 81.16'
c/l St. sign - SE. 50.40'
Guy pole - SSW. 103.76' | Merdzinski - 1980 per
L.C.R.C. recorded in
L. 4, P. 47
Iron
Nail in c/l 8" Elm - N65°E 113.0'
Nail in c/l 8" Ash - S45°W 82.15'
Nail in c/l 5" Ash - S30°W 64.4'
Nail in c/l P. pole - S30°E 81.20' |
|--|---|---|

B. Description of corner evidence found and/or method applied in restoring or reestablishing corner:

- K-7**
Found C.I. mon. in mon. box
Found P.K. nail in NE. side P. pole - S51°E 61.00'
Found K.K. nail in NE. side P. pole - S31°E 81.42'
Found nail in SE. side tw. Cottonwood - N74°E 96.70'
c/l E.-W. Bit. Conc. road - S. 2.0'
c/l N.-S. Bit. Conc. road - E. 0.4'
- Joiner - 1984 per L.C.R.C. recorded in L. 5, P. 176
C.I.M.
7" Willow - NE. 96.75'
P. pole - SE. 81.26'
6" Ash - SSW. 64.26'
7" Ash - WSW 82.09'
- G.L.O. - 1838 signed by
R. Whitcomb
8" B. Ash - S35°W .24 ch.
10" Maple - N71°E .23 ch.

C. Description of monument for corner and accessories established to perpetuate locating the position of the corner:

- K-7**
C.I. mon. in mon. box
Set nail and remon. tag in E. side 7" Elm - S42°W 76.65'
Set nail and remon. tag in NE. side P. pole - S51°E 61.00'
Set nail and remon. tag in NE. side P. pole - S31°E 81.42'
Set nail and remon. tag in SE. side tw. 7" Willow - N74°E 96.70'

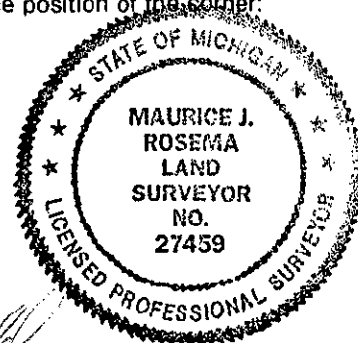

P.A. 345 OTTAWA COUNTY

PEER APPROVED 4/18/94

Signed by

Maurice J. Rosema
Maurice J. Rosema
27459

Date April 18, 1994

FORM APPROVED BY MICHIGAN STATE BOARD OF LAND SURVEYORS, JAN. 28, 1971
REVISED MAY 14, 1975
REVISED JAN., 1983