

SURVEY & REMONUMENTATION

Ottawa County Remonumentation

APR 24 1995

RECORDED

COMMISSION

LAND CORNER RECORDATION CERTIFICATE
Filing Requirement of Act 74, Mich. P.A. 1970

94 DEC 15 AM 11:53

For corners in

Ottawa (County)	Located In:	Corner Code #
1. Public Land Survey	T <u>7N</u> R <u>13W</u>	<u>K-8</u>
	T _____ R _____	_____
	T _____ R _____	_____
	T _____ R _____	_____
2. Property Controlling in Section	S _____ T _____ R _____	_____
	S _____ T _____ R _____	_____
3. Miscellaneous Property in Sec.	S _____ T _____ R _____	_____
	S _____ T _____ R _____	_____

Phyllis Callman
REGISTER OF DEEDS
OTTAWA COUNTY, MI

Register of Deeds Stamp & File Number

4. Lot No. _____, Recorded Plat _____
5. Private Claims _____

	A	B	C	D	E	F	G	H	I	J	K	L	M
2	6		5		4		3		2		1		
3													
4	7		8		9		10		11		12		
5													
6	18		17		16		15		14		13		
7													
8	19		20		21		22		23		24		
9													
10	30		29		28		27		26		25		
11													
12	31		32		33		34		35		36		
13													

Maurice J.
Rosema

Dec. 9 94

I, _____, in a field survey on _____, 19 _____, do hereby certify that under requirements of P.A. 74, Michigan P.A. of 1970, the corner points mentioned in lines 1 and 2 above were in conformance with regulations and rules therefore as required in the current manual of survey instructions of the United States Department of the Interior, Bureau of Land Management or by a decree of a Court of Law and/or that the corner points mentioned in lines 3, 4 and 5 above were in conformance with the rules of the Michigan Board of Land Surveyors or by a Decree of a Court of Law; established, re-established, monumented, re-monumented, recovered, found as expressed below:

NOTE: Not more than 4 corners, all in the same town and range, may be recorded on this certificate.

A. Description of original monument and accessories and/or subsequent restoration:

K-8
GLO - 1838 by VanKooten - 1977 per L.C.R.C. Merdzinski - 1980 per
R. Whitcomb rec. in L. 3, P. 242 L.C.R.C. rec. in L.
40" Oak at (over) 4, P. 47 (over)
Sec. cor. Rosema - 1987 per L.C.R.C. Joiner - 1990 per
rec. in L. 5, P. 282 L.C.R.C. rec. in L.
(over) 6, P. 81 (over)

B. Description of corner evidence found and/or method applied in restoring or reestablishing corner:


K-8
Found C.I. mon. in mon. box
Found nail in N. side 17" Oak - N84°W 25.61'
Found nail in N. side 32" Oak - S89°E 27.56'

P.A. 345 OTTAWA COUNTY
PEER APPROVED 12/12/94
Robert D. Nedwell

I hereby accept this corner as a correct and accurate perpetuation of the position of the original corner.

C. Description of monument for corner and accessories established to perpetuate locating the position of the corner:

K-8
C.I. mon. in mon. box
Set nail and remon. tag in N. side 17" Oak - N84°W 25.61'
Set nail and remon. tag in N. side 32" Oak - S89°E 27.56'
Set nail and remon. tag in NE. side Power pole - S41°E 78.75'
Set nail and remon. tag in E. side Power pole - N15°W 119.31'

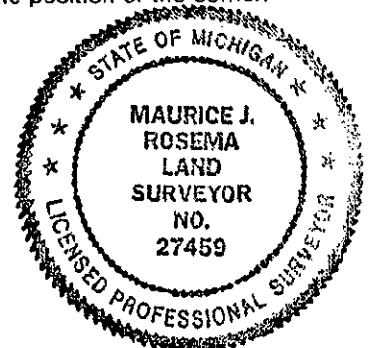

Signed by *Maurice J. Rosema*
Surveyor's Michigan License No. 27459

Date Dec. 10, 1994

