

SURVEY &
REMONUMENTATION

APR 05 1996

Ottawa County Remonumentation

LAND CORNER RECORDATION CERTIFICATE

COMMISSION Filing Requirement of Act 74, Mich. P.A. 1970

For corners in

<u>Ottawa</u> <small>(County)</small>	Located In:	Corner Code #
1. Public Land Survey	T <u>T7N</u> R <u>R13W</u>	<u>K-11</u>
	T _____ R _____	<u>(SE cor of</u>
	T _____ R _____	<u>Sec. 26)</u>
	T _____ R _____	<u>Tallmadge Twp</u>
2. Property Controlling in Section	S _____ T _____ R _____	_____
	S _____ T _____ R _____	_____
3. Miscellaneous Property in Sec.	S _____ T _____ R _____	_____
	S _____ T _____ R _____	_____

RECORDED

95 NOV 29 PM 1:45

D. J. ...
REGISTER OF DEEDS
OTTAWA COUNTY, MI

Register of Deeds Stamp & File Number

4. Lot No. _____, Recorded Plat _____
5. Private Claims _____

A	B	C	D	E	F	G	H	I	J	K	L
2	6	5	4	3	2	1					
3											
4	7	8	9	10	11	12					
5											
6	18	17	16	15	14	13					
7											
8	19	20	21	22	23	24					
9											
10	30	29	28	27	26	25					
11											
12	31	32	33	34	35	36					
13											

Maurice J. Rosema, in a field survey on March 1, 1995, do hereby certify that under requirements of P.A. 74, Michigan P.A. of 1970, the corner points mentioned in lines 1 and 2 above were in conformance with regulations and rules therefore as required in the current manual of survey instructions of the United States Department of the Interior, Bureau of Land Management or by a decree of a Court of Law and/or that the corner points mentioned in lines 3, 4 and 5 above were in conformance with the rules of the Michigan Board of Land Surveyors or by a Decree of a Court of Law; established, re-established, monumented, re-monumented, recovered, found as expressed below:

NOTE: Not more than 4 corners, all in the same town and range, may be recorded on this certificate.


A. Description of original monument and accessories and/or subsequent restoration:

K-11	
GLO - 1838 (R. Whitcomb D.S.)	L.C.R.C. recorded in Liber 6,
12" White Oak N77°E 38lks	Page 1 - January 16, 1989
14" White Oak S78°W 60lks	(over)
L.C.R.C. recorded in Liber 6,	L.C.R.C. recorded in Liber 3,
Page 81 - December 3, 1990	Page 138 - September 17, 1976
(over)	(over)

B. Description of corner evidence found and/or method applied in restoring or reestablishing corner:

K-11
Found C.I. monument
Found nail in P.Pole NW 45.34' PEER APPROVED 11-20-95
Found nail in P.Pole NE 95.14'
Found nail in 31" Oak SE 49.63'
Found nail in 31" Willow SW 56.10'

Maurice J. Rosema
YDN

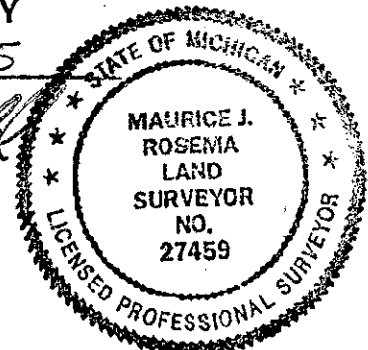

I hereby accept this corner as a correct and accurate perpetuation of the position of the original corner.

C. Description of monument for corner and accessories established to perpetuate locating the position of the corner:

K-11
C.I. monument
Set nail and Ottawa County remon. tag in NE side P pole N42°W 45.34'
Set nail and Ottawa County remon. tag in NW side P pole N34°E 95.14'
Set nail and Ottawa County remon tag in SW side 31" Oak S35°E 49.63'
Set nail and Ottawa County remon. tag in S side 31" Willow S28°W 56.10'
On c/l N-S bit. conc. road
Tree row to E S 4'

Signed by *Maurice J. Rosema* Date October 20, 1995
Surveyor's Michigan License No. 27459

K-11, T7N, R13W

L.C.R.C. recorded in Liber 3, Page 138
- September 17, 1976

1" pipe	
30" Oak	SE 49.55'
24" Willow	SW 57.83'
PP	NW 45.37'
36" Maple	NE 53.36'

L.C.R.C. recorded in Liber 6, Page 1
- January 16, 1989

MVK re-rod	
Nail in SW side 30" Elm	S40°E 49.57'
Nail in E side 36" Willow	S40°W 56.14'
PK in NE side P pole	N45°W 45.43'

L.C.R.C. recorded in Liber 6, Page 81
- December 3, 1990

C.I. monument	
30" Oak	SE 49.55'
30" Willow	SW 56.08'
PP	NE 95.03'
TP	NW 45.36'

* 11.00 CORNER