

**SURVEY &
REMONUMENTATION**

Ottawa County Remonumentation
APR 05 1996 **LAND CORNER RECORDATION CERTIFICATE**
COMMISSION Filing Requirement of Act 74, Mich. P.A. 1970

For corners in

Ottawa
(County)

Located In:

Corner Code: #

- | | | | | | |
|------------------------------------|---|------------|---|-------------|-------------------------|
| 1. Public Land Survey | T | <u>T7N</u> | R | <u>R13W</u> | K-12 |
| | T | | R | | (E $\frac{1}{4}$ cor of |
| | T | | R | | Section 35) |
| | T | | R | | Tallmadge Twp |
| 2. Property Controlling in Section | S | | T | R | |
| | S | | T | R | |
| 3. Miscellaneous Property in Sec. | S | | T | R | |
| | S | | T | R | |

RECORDED

95 NOV 15 PM 2:06

R. J. Rosema
 REGISTER OF DEEDS
 OTTAWA COUNTY, MI

Register of Deeds Stamp & File Number

4. Lot No. _____, Recorded Plat _____
 5. Private Claims _____

I, Maurice J. Rosema, in a field survey on March 1, 1995, do hereby certify that under requirements of P.A. 74, Michigan P.A. of 1970, the corner points mentioned in lines 1 and 2 above were in conformance with regulations and rules therefore as required in the current manual of survey instructions of the United States Department of the Interior, Bureau of Land Management or by a decree of a Court of Law and/or that the corner points mentioned in lines 3, 4 and 5 above were in conformance with the rules of the Michigan Board of Land Surveyors or by a Decree of a Court of Law, established, re-established, monumented, re-monumented, recovered, found as expressed below:

A	B	C	D	E	F	G	H	I	J	K	L	M
2	6	5	4	3	2	1						
3												
4	7	8	9	10	11	12						
5												
6	18	17	16	15	14	13						
7												
8	19	20	21	22	23	24						
9												
10	30	29	28	27	26	25						
11												
12	31	32	33	34	35	36						
13												

NOTE: Not more than 4 corners, all in the same town and range, may be recorded on this certificate.

A. Description of original monument and accessories and/or subsequent restoration:

K-12
 GLO - 1838 (R. Whitcomb D.S.)
 16" White Oak N69°E 10lks
 8" White Oak N14° W 44lks

L.C.R.C. recorded in Liber 2,
 Page 189 - September 20, 1972
 (over)


L.C.R.C. recorded in Liber 6,
 Page 82 - December 3, 1990
 (over)

P.A. 345 OTTAWA COUNTY
PEER APPROVED 10/23/95

M. J. Rosema *Murray D. Newbold*

B. Description of corner evidence found and/or method applied in restoring or reestablishing corner:

K-12
 Found C.I. monument in monument box
 Found nail in 19" Hickory NW 57.39'
 Found nail in 17" Hickory SSW 53.28'
 Found nail in P.pole SE 91.68'

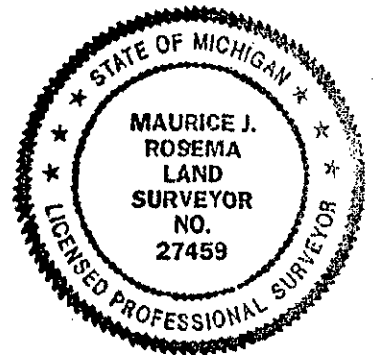

I hereby accept this corner as a correct and accurate perpetuation of the position of the original corner.

C. Description of monument for corner and accessories established to perpetuate locating the position of the corner:

K-12
 C.I. monument in monument box
 Set nail and Ottawa County remon. tag in SW side 19" Hickory N46°W 57.39'
 Set nail and Ottawa County remon. tag in SW side 14" Hickory N53°W 63.78'
 Set nail and Ottawa County remon. tag in E side 17" Hickory (5' above ground) S13°W 53.28'
 Set nail and Ottawa County remon. tag in NE side P pole S60°E 91.68'
 On c/l E-W bit, conc. road
 On c/l bit, conc. road to N

Signed by *M. J. Rosema* Date October 21, 1995
 Surveyor's Michigan License No. 27459

K-12, T7N, R13W

L.C.R.C. recorded in Liber 2, Page 189
- September 20, 1972

T-iron	
T pole	SE 52.75'
20" Hickory	NW 56.64'
16" Oak	WNW 124.33'
12" Walnut	NNW 88.57'

L.C.R.C. recorded in Liber 6, Page 82
- December 3, 1990

C.I. monument	
16" Hickory	S 42.12'
36" Oak	SW 64.60'
36" Oak	N 83.30'
33" Oak	SE 61.72'

\$ 11.00 CORNER