

SURVEY &
REMONUMENTATION

DEC 01 1998

OTTAWA COUNTY REMONUMENTATION
LAND CORNER RECORDATION CERTIFICATE
Filing Requirement of Act 74, Mich. P.A. 1970

SECTION

For corners in

Ottawa	Located In:	Corner Code #
(County)	Tallmadge Township	
1. Public Land Survey	T <u>7N</u> R <u>13W</u>	<u>K-13</u>
	T _____ R _____	SW Cor. Sec. 36
	T <u>6N</u> R <u>13W</u>	<u>K-1</u>
	T _____ R _____	
2. Property Controlling in Section	S _____ T _____ R _____	
	S _____ T _____ R _____	
3. Miscellaneous Property in Sec.	S _____ T _____ R _____	
	S _____ T _____ R _____	
4. Lot No. _____, Recorded Plat _____		
5. Private Claims _____		

RECORDED

98 JUL 26 PM 1:47

Ray Roberts
REGISTER OF DEEDS
OTTAWA COUNTY, MI

Register of Deeds Stamp & File Number

I, Rodney D. Unema, in a field survey on May 21, 19 98, do hereby certify that under requirements of P.A. 74, Michigan P.A. of 1970, the corner points mentioned in lines 1 and 2 above were in conformance with regulations and rules therefore as required in the current manual of survey instructions of the United States Department of the Interior, Bureau of Land Management or by a decree of a Court of Law and/or that the corner points mentioned in lines 3, 4 and 5 above were in conformance with the rules of the Michigan Board of Land Surveyors or by a Decree of a Court of Law; established, re-established, monumented, re-monumented, recovered, found as expressed below:

A	B	C	D	E	F	G	H	I	J	K	L	M
2	6	5	4	3	2	1						
3												
4	7	8	9	10	11	12						
5												
6	18	17	16	15	14	13						
7												
8	19	20	21	22	23	24						
9												
10	30	29	28	27	26	25						
11												
12	31	32	33	34	35	36						
13												

NOTE: Not more than 4 corners, all in the same town and range, may be recorded on this certificate.

A. Description of original monument and accessories and/or subsequent restoration:

K-13 G.L.O.
April, 1837 R. Clark Jr.
Set post at 80.00 Chains
6" B. Ash N7°30'E 24 Links
12" B. Ash N46°30'W 41 Links

No recorded witnesses for this corner
From W & W witness map:
"T" Iron - 8" Elm East 11.3'
- 8" Elm S 27.35'
- 9" Ash SE 42.95'
Common corner with K-1, T6N, R13W

(OVER)

B. Description of corner evidence found and/or method applied in restoring or reestablishing corner:

K-13
Found Steel Fence Post in swampy area
Found 6" Stump N90°E 23.0'
Found 10" Stump S0°E 43.3'

*Over for sketch


Accepted as a careful and faithful perpetuation of the position of this original corner.

P.A. 845 OTTAWA COUNTY
PEER APPROVED 6-1-98
R.D.U.

C. Description of monument for corner and accessories established to perpetuate localizing the position of the corner:

K-13
Steel Fence Post in swamp
Set nail & O.C. tag in N'ly side 22" Willow S50°W 50.58'
Set nail & O.C. tag in N'ly side 4" Oak S88°E 66.38'
Set nail & O.C. tag in W'ly side Service Pole N5°W 159.20'
S 1/4 corner Sec. 36 East 2615.98'

CORNER IS COMMON WITH K-1, T6N, R13W

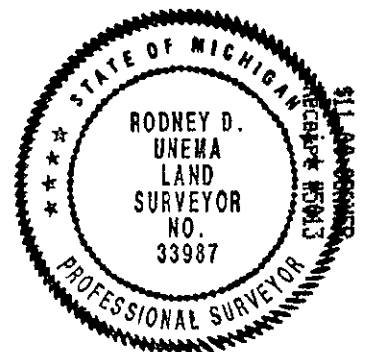

Signed by Rodney D. Unema Date May 29, 1998
Surveyor's Michigan License No. 33987

