

**SURVEY &
MONUMENTATION**

Ottawa County Remonumentation

APR 05 1996 LAND CORNER RECORDATION CERTIFICATE

Filing Requirement of Act 74, Mich. P.A. 1970

For corners in

COMMISSION

Ottawa <small>(County)</small>	Located In:	Corner Code #
1. Public Land Survey	T <u>7N</u> R <u>13W</u>	L-3
	T _____ R _____	(S $\frac{1}{4}$ cor. of
	T _____ R _____	Section 1)
	T _____ R _____	Tallmadge Twp
2. Property Controlling in Section	S _____ T _____ R _____	_____
	S _____ T _____ R _____	_____
3. Miscellaneous Property in Sec.	S _____ T _____ R _____	_____
	S _____ T _____ R _____	_____

RECORDED

95 NOV 15 PM 2:06

Ralph R. Robinson
REGISTER OF DEEDS
OTTAWA COUNTY, MI

Register of Deeds Stamp & File Number

4. Lot No. _____, Recorded Plat _____
5. Private Claims _____

	A	B	C	D	E	F	G	H	I	J	K	L	M
2	6		5		4		3		2		1		
3													
4	7		8		9		10		11		12		
5													
6	18		17		16		15		14		13		
7													
8	19		20		21		22		23		24		
9													
10	30		29		28		27		26		25		
11													
12	31		32		33		34		35		36		
13													

Maurice J. Rosema, in a field survey on Feb. 24, 1995, do hereby certify that under requirements of P.A. 74, Michigan P.A. of 1970, the corner points mentioned in lines 1 and 2 above were in conformance with regulations and rules therefore as required in the current manual of survey instructions of the United States Department of the Interior, Bureau of Land Management or by a decree of a Court of Law and/or that the corner points mentioned in lines 3, 4 and 5 above were in conformance with the rules of the Michigan Board of Land Surveyors or by a Decree of a Court of Law; established, re-established, monumented, re-monumented, recovered, found as expressed below:

NOTE: Not more than 4 corners, all in the same town and range, may be recorded on this certificate.

A. Description of original monument and accessories and/or subsequent restoration:


L-3
GLO - 1838 (R. Whitcomb D.S.) L.C.R.C. recorded in Liber 4, Page 260
12" Sugar N80°E 17 lks - December 4, 1981
6" Beech N74°W 27 lks (over)

L.C.R.C. recorded in Liber 5, Page 314 L.C.R.C. recorded in Liber 1, Page 719
- May 17, 1988 - November 1, 1972
(over)

B. Description of corner evidence found and/or method applied in restoring or reestablishing corner:

L-3
Found 1/2" steel rod in monument box, replaced with 3/4" X 2' steel rod with Ottawa County remon. cap
Found nail and tag in 22" stump N 32.51'

I hereby accept this corner as a correct and accurate perpetuation of the position of the original corner.

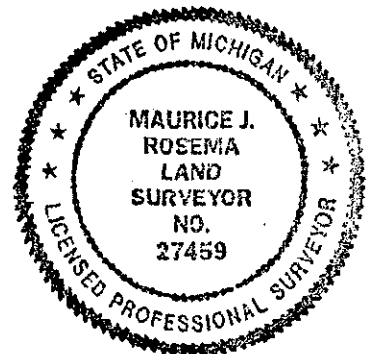

C. Description of monument for corner and accessories established to perpetuate locating the position of the corner:

L-3
3/4" X 2' steel rod in monument box
Set nail and Ottawa County remon. tag in W side 22" stump N0°W 32.51'
Set nail and Ottawa County remon. tag in E side 5" Maple N12°W 42.38'
Set nail and Ottawa County remon. tag in NW side 23" Oak N46°E 113.52'
Set nail and Ottawa County remon. tag in E side 9" Maple S26°W 158.33'
Set nail and Ottawa County remon. tag in S side 23" Maple N73°W 182.88'
On c/l E-W bit. conc. road

P.A. 345 OTTAWA COUNTY

PEER APPROVED

10/23/95

Signed by

Maurice J. Rosema

Date

October 21, 1995

Surveyor's Michigan License No.

27459

FORM APPROVED BY MICHIGAN STATE BOARD OF LAND SURVEYORS, JAN. 28, 19
REVISED MAY 14, 15
REVISED JAN. 15

L-3, T7N, R13W

L.C.R.C. recorded in Liber 1, Page 719

- November 1, 1972

3/4" iron

SW corner hse fndn

SE corner hse fndn

Nail in side 20" Maple

Nail in side T pole

Nail in side 30" W Cherry

c/1 gravel

NNE 235.75'

WNW 221.45'

N 32.18'

WNW 47.98'

SW 42.98'

N 4'±

L.C.R.C. recorded in Liber 4, Page 260

- December 4, 1981

C.I. monument

7" Elm

30" Maple

9" Basswood

8" Maple

S 19.05'

SW 42.96'

WSW 87.16'

NE 67.89'

L.C.R.C. recorded in Liber 5, Page 314

- May 17, 1988

1/2" re-rod in monument box

PK in E side 10" Maple

PK in W side 14" Maple

PK in SE side 20" Oak

N15°E 68.11'

N10°W 47.01'

N50°E 114.20'

\$ 11.00
CORNER