

FEB 24 2000

RECORDED

99 OCT 27 PM 1:49

SECTION

Ottawa County Remonumentation
LAND CORNER RECORDATION CERTIFICATE
Filing Requirement of Act 74, Mich. P.A. 1970

Sam Schmitt
REGISTER OF DEEDS
OTTAWA COUNTY, MI

For corners in

<u>Ottawa</u> (County)	Located In:	Corner Code #
1. Public Land Survey	T <u>7NR 13W</u>	<u>L-9</u>
	T ___ R ___	<u>N 1/4 corner, Section 25</u>
	T ___ R ___	<u>Tallmadge Township</u>
	T ___ R ___	_____
2. Property Controlling in Section	S ___ T ___ R ___	_____
	S ___ T ___ R ___	_____
3. Miscellaneous Property in Sec.	S ___ T ___ R ___	_____
	S ___ T ___ R ___	_____

Register of Deeds Stamp & File Number

4. Lot No. _____, Recorded Plat _____
5. Private Claims _____

I, Maurice J. Rosema, in a field survey on Sept. 9, 1999 do hereby state that under requirements of P.A. 74, Michigan P.A. of 1970, the corner points mentioned in lines 1 and 2 above were in conformance with regulations and rules therefore as required in the current manual of survey instructions of the United States Department of the Interior, Bureau of Land Management or by a decree of a Court of Law and/or that the corner points mentioned in lines 3, 4 and 5 above were in conformance with the rules of the Michigan Board of Land Surveyors or by a Decree of a Court of Law, established, re-established, monumented, recovered, found as expressed below:

NOTE: Not more than 2 corners, all in the same town and range, may be recorded on this certificate.

1	A	B	C	D	E	F	G	H	I	J	K	L	M
2		6		5		4		3		2		1	
3													
4		7		8		9		10		11		12	
5													
6		18		17		16		15		14		13	
7													
8		19		20		21		22		23		24	
9													
10		30		29		28		27		26		25	
11													
12		31		32		33		34		35		36	
13													

A. Description of original monument and accessories and/or subsequent restoration:

L-9
 GLO - 1838 LCRC per Liber 2, Page 763
 R. Whitcomb D.S. (Spicer - 1975)
 Set post Iron in mon. box
 20" W. Oak - S83°E CP pole - SW45°W 111.02'
 40 links NE. cor. house - S10°W 125.65'
 12" W. Oak - S73°W C/L pavt - S. 1.8'
 44 links C/L x sts - E. 165.2'

B. Description of corner evidence found and/or method applied in restoring or reestablishing corner:


L-9
 Found 3/4" iron rod in monument box, replaced iron rod with 3/4" x 3' steel rod with remonumentation cap
 NE. corner of house (siding) - S10°W 125.65'
 Centerline of E.-W. bit. conc. road - S. 1.8'
 Centerline of bit. conc. road to S. - E. 165'±

I hereby accept this corner as a correct and accurate perpetuation of the position of the original corner.

C. Description of monument for corner and accessories established to perpetuate locating the position of the corner:

L-9
 3/4" x 3' steel rod with remonumentation cap in monument box
 Set nail and remonumentation tag in W. side Power pole - N25°W 73.78'
 Set nail and remonumentation tag in W. side Power pole - N1°E 68.10'
 Set nail and remonumentation tag in E. side Power pole - S66°W 110.90'
 NE. corner of house (siding) - S10°W 125.65'
 Centerline of E.-W. bit. conc. road - S. 1.8'

9/13/99
YDZ

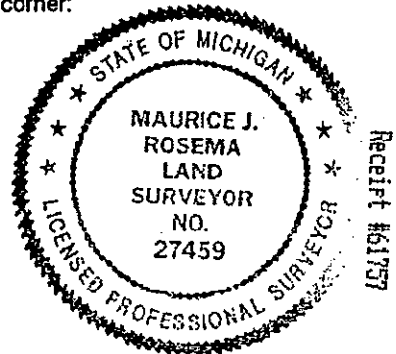

Signed by *Maurice J. Rosema*
 Surveyor's Michigan License No. 27459

Date September 11, 1999