

APR 05 1996 Ottawa County REmonumentation
COMMISSION LAND CORNER RECORDATION CERTIFICATE
 Filing Requirement of Act 74, Mich. P.A. 1970

RECORDED

95 DEC 12 PM 4: 53

Phyllis Robinson
 REGISTER OF DEEDS
 OTTAWA COUNTY, MI

For corners in

Ottawa (County)	Located In:	Corner Code #
1. Public Land Survey	T T7N R R13W	M-3
	T R	
	T R	
	T R	
2. Property Controlling in Section	S T R	
	S T R	
3. Miscellaneous Property in Sec.	S T R	
	S T R	

Register of Deeds Stamp & File Number

4. Lot No. _____, Recorded Plat _____
 5. Private Claims _____

	A	B	C	D	E	F	G	H	I	J	K	L	M
2	6	5	4	3	2	1							
3													
4	7	8	9	10	11	12							
5													
6	16	17	16	15	14	13							
7													
8	19	20	21	22	23	24							
9													
10	30	29	28	27	26	25							
11													
12	31	32	33	34	35	36							
13													

I, Maurice J. Rosema, in a field survey on Oct. 10, 1995, do hereby certify that under requirements of P.A. 74, Michigan P.A. of 1970, the corner points mentioned in lines 1 and 2 above were in conformance with regulations and rules therefore as required in the current manual of survey instructions of the United States Department of the Interior, Bureau of Land Management or by a decree of a Court of Law and/or that the corner points mentioned in lines 3, 4 and 5 above were in conformance with the rules of the Michigan Board of Land Surveyors or by a Decree of a Court of Law; established, re-established, monumented, re-monumented, recovered, found as expressed below:

NOTE: Not more than 4 corners, all in the same town and range, may be recorded on this certificate.

A. Description of original monument and accessories and/or subsequent restoration:
 M-3

GLO - 1837 by Noah Brookfield D.S. Set post 10" Sugar S79°W 15 lks. 9" Sugar N12°W 27 lks.	L.C.R.C. recorded as #5497, A-3, T7N, R12W - June 6, 1990 (over)
	L.C.R.C. recorded as #802, A-3, T7N, R12W - July 23, 1975 (over)

P.A. 345 OTTAWA COUNTY
 PEER APPROVED 12/11/95

Kendry D. Redwood
YDM


B. Description of corner evidence found and/or method applied in restoring or reestablishing corner:
 M-3

Found C.I. mon.	
Found nail and K.C. tag in W side 30" Maple	S22°W 49.18'
Found nail and K.C. tag in SE side P pole	S19°E 86.67'
Found nail and K.C. tag in N side P pole	N8°E 86.80'

I hereby accept this corner as a correct and accurate perpetuation of the position of the original corner.

C. Description of monument for corner and accessories established to perpetuate locating the position of the corner:
 M-3

C.I. mon.	
Found nail and K.C. tag in W side 30" Maple	S22°W 49.18'
Found nail and K.C. tag in S side 30" Maple	N72°W 127.64'
Found nail and K.C. tag in SE side P pole	S19°E 86.67'
Found nail and K.C. tag in N side P pole	N8°E 86.80'
Centerline of E-W bit. conc. road	N 1'
Centerline of NW-SE bit. conc. road	NE 25'
Centerline of bit. conc. road to S	E 5'

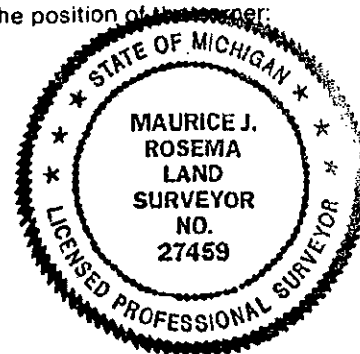

Signed by *Maurice J. Rosema* Date October 21, 1995
 Surveyor's Michigan License No. 27459

M-3, T7N, R13W

L.C.R.C. recorded as #5497,

A-3, T7N, R12W

K.C. mon.

Nail and K.C. tag in W side P pole

S20°E 86.65'

Nail and K.C. tag in N side P pole

S75°E 131.86'

Nail and K.C. tag in E side P pole

N5°E 86.86'

Nail and K.C. tag in W side 30" Maple

S25°W 49.34'

Nail and K.C. tag in S side 30" Maple

N70°W 107.92'

Top c/l MBT box

N55°W 98.62'

c/l Remembrance Road

E 34'±

On c/l gravel road to S (Kenowa Ave.)

On c/l bit. road E-W (3 Mile Road)

On tree row to N

L.C.R.C. recorded as #802,

A-3, T7N, R12W

1" iron

32.75' W of centerline of M-11, at intersection of the centerline South of
Kenowa NW and 3 Mile Road

Nail in SW side CP P pole

Az. 03° 86.85'

Nail in E side 28" Maple

Az. 245° 60.22'

Nail in SW side 36" Maple

Az. 295° 68.90'