

APR 05 1996

Ottawa County Remonumentation
LAND CORNER RECORDATION CERTIFICATE

COMMISSION Filing Requirement of Act 74, Mich. P.A. 1970

For corners in

<u>Ottawa</u> (County)	Located In:	Corner Code #
1. Public Land Survey	T <u>T7N</u> R <u>R13W</u>	<u>M-5</u>
	T _____ R _____	<u>(SE cor of</u>
	T _____ R _____	<u>Section 12)</u>
	T _____ R _____	<u>Tallmadge Twp</u>
2. Property Controlling in Section	S _____ T _____ R _____	_____
	S _____ T _____ R _____	_____
3. Miscellaneous Property in Sec.	S _____ T _____ R _____	_____
	S _____ T _____ R _____	_____

RECORDED
95 NOV 15 PM 2:06
Dorothy B. Bellman
REGISTER OF DEEDS
OTTAWA COUNTY, MI

Register of Deeds Stamp & File Number

4. Lot No. _____, Recorded Plat _____
5. Private Claims _____

A	B	C	D	E	F	G	H	I	J	K	L	M
2	6	5	4	3	2	1						
3												
4	7	8	9	10	11	12						
5												
6	18	17	16	15	14	13						
7												
8	19	20	21	22	23	24						
9												
10	30	29	28	27	26	25						
11												
12	31	32	33	34	35	36						
13												

Maurice J. Rosema, in a field survey on March 2, 19 95, do hereby certify that under requirements of P.A. 74, Michigan P.A. of 1970, the corner points mentioned in lines 1 and 2 above were in conformance with regulations and rules therefore as required in the current manual of survey instructions of the United States Department of the Interior, Bureau of Land Management or by a decree of a Court of Law and/or that the corner points mentioned in lines 3, 4 and 5 above were in conformance with the rules of the Michigan Board of Land Surveyors or by a Decree of a Court of Law; established, re-established, monumented, re-monumented, recovered, found as expressed below:

NOTE: Not more than 4 corners, all in the same town and range, may be recorded on this certificate.

A. Description of original monument and accessories and/or subsequent restoration:
M-5


GLO - 1837 (Noah Brookfield D.S.) 10" Beech S70°W 50lks 10" Beech N51°W 44lks	L.C.R.C. recorded in Liber 3, Page 133 - November 29, 1976 (over)	L.C.R.C. recorded as no. 1847 - June 10, 1981 (over)
L.C.R.C. recorded in Liber 6, Page 178 - October 10 1991 (over)	L.C.R.C. recorded as no. 5499 - May 14, 1990 (over)	

P.A. 345 OTTAWA COUNTY
PEER APPROVED 10/23/95

B. Description of corner evidence found and/or method applied in restoring or reestablishing corner:
M-5

Found C.I. monument	
Found nail in P.pole	NW 36.97'
Found Street sign	SW 32.25'
Found nail and Kent County remon. tag in NE side P pole	
Found nail and Kent County remon. tag in SE side P pole	
Found nail and Kent County remon. tag in S side P pole	

NW 36.97'
SW 63.36'
SE 37.89'

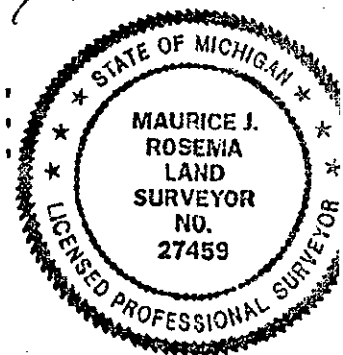

I hereby accept this corner as a correct and accurate perpetuation of the position of the original corner.

C. Description of monument for corner and accessories established to perpetuate locating the position of the corner:
M-5

Set nail and Ottawa County remon. tag in E side 28" Maple	N22°W 60.34'
Found nail and Kent County remon. tag in NE side P pole	N38°W 36.97'
Found nail and Kent County remon. tag in SE side P pole	S50°W 63.36'
c/l (base) street sign	S40°W 32.25'
Found nail and Kent County remon. tag in S side P pole	S41°E 37.89'
On c/l bit, conc. road to N	
c/l E-W bit, conc. road	N 1'

Signed by Maurice J. Rosema
Surveyor's Michigan License No. 27459

Date October 21, 1995

M-5, T7N, R13W

L.C.R.C. recorded in Liber 3, Page 133

- November 29, 1976

3" Pipe
Guy pole NW 36.35'
T pole NE 41.17'
L pole SE 37.20'
St sign SW 32.45'

L.C.R.C. recorded in Liber 6, Page 178

- October 10, 1991

K.C. monument
Guy Pole NW 36.89'
T pole NE 41.18'
T pole SE 37.90'

L.C.R.C. recorded as no. 1847

- June 10, 1981 (recorded as: A-5, T7N, R12W)

K.C. Harrison monument
K.C. nail and tag in P pole S50°E 32.20'
K.C. nail and tag in 36" Maple N30°W 59.54'
K.C. nail and tag in P pole N50°E 36.92'
K.C. nail and tag in fc post S45°W 45.70'
3/4" iron E 4.95'

L.C.R.C. recorded as no. 5499

- May 14, 1990 (recorded as: A-5, T7N, R12W)

K.C. monument
Nail and K.C. tag in SW side P pole S45°E 37.89'
Nail and K.C. tag in NE side P pole N40°W 36.92'
Nail and K.C. tag in E side P pole S50°W 63.25'
Nail and K.C. tag in W side P pole N50°E 41.20'
3/4" iron E 4.95'
On c/l E-W bit. conc. road
On c/l gravel road N-S

\$ 11.00 CORNER